

CHARLES O. GEORGI COMPANY

2215 West County Road B

Saint Paul, Minnesota 55113

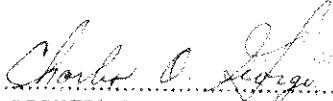
REGISTERED CIVIL ENGINEER AND LAND SURVEYOR

Certificate of Survey

Walkway & Escalator
I Hereby Certify that this plat shows a building location survey made by me on the property described on this plat, and that all locations, have been correctly shown. ^{8/28/74 Completed data.} _{9/6/74 Added modifications and changes.}

Date August 1974

By


REGISTERED LAND SURVEYOR

For: Housing Authority & Transamerica.

New Transamerica Building
St. Paul, Minn.

Attached herewith are 10 Sheets of descriptions for walkways and Escalators located within the boundary lines of the building site. Also attached herewith are drawings A and B that delineate each description.

The parcels of land for public use as an easement is limited in height vertically as well as horizontally without overlapping either way in space.

The areas included herein are in accord with 2 marked up plans from Thomas F. Marshall and enlarged and furnished by the Housing Authority dated November 6, 1972 and received by me July 1974

Each area has been measured in the field under my direct supervision to provide as built distances and elevations. Stipulated surfaces are to be used where uneven or irregular surfaces are found to vary a small amount from the description values.

All areas are calculated to the nearest one Square foot for each parcel as given.

Total Areas are as follows:

First Floor = 1832 Sq. Ft.

Escalators = 663 Sq. Ft.

Second Floor = 7,083 Sq. Ft.

To the best of my knowledge each parcel is subjected to whatever encroachment or condition in the form of doorways, railings, lights or signs that exist in space therein.