FROM THE OFFICE OF

CHARLES O. GEORGI COMPANY

2215 West County Road B — Saint Paul, Minnesota

MINNESOTA REGISTERED LAND SURVEYOR

Certificate of Survey

I Hereby Certify that this plat shows a survey made by me of the property described on this plat, and that the corners are correctly placed as shown, and that all locations, encroachments, etc., have been correctly shown.

To Whom it may concern.

Surveyed For American National Bank & Weld Assoc, Architects

Date November 1972

Scale 1" = 50'

By Charles O. Georgi

REGISTERED LAND SURVEYOR

Description:

All that part of Lots 1, 2, 3, 4, 5, 6, 7 and 8, Block 11, City of St. Paul described as follows:

All that part of said Lots 1, 2, 3, 4, 5 and 8, lying Northerly of a line distant 175.01 feet Northerly at right angles and parallel with the Southerly line of said Block 11, except the Northerly 2 feet of said Lots 4 and 5 for widening East Sixth Street, except the Westerly 2 feet of said Lot 8 for widening Minnesota Street, and except the Easterly 20 feet of said Lot 1 taken for widening Robert Street.

and All that part of said Lots 6 and 7, except the Northerly 2 feet of said Lot 6 for widening East Sixth Street, and except the Westerly 2 feet of Lots 6 and 7 for widening Minnesota Street.

Together with an easement for ingress and egress over and across the Northerly 2 feet of said Lots 4, 5 and 6 of said Block 11, and the Westerly 2 feet of Lots 6, 7 and 8, all as described herein, as reserved for widening of Minnesota Street and Sixth Street, said easement to remain in force and effect until dedication of said property for street purposes, and then terminating.

3 ~~2~~ Copies to Arthur
2 Copies to Bart Bobes
2 Copies to Weld Assoc.
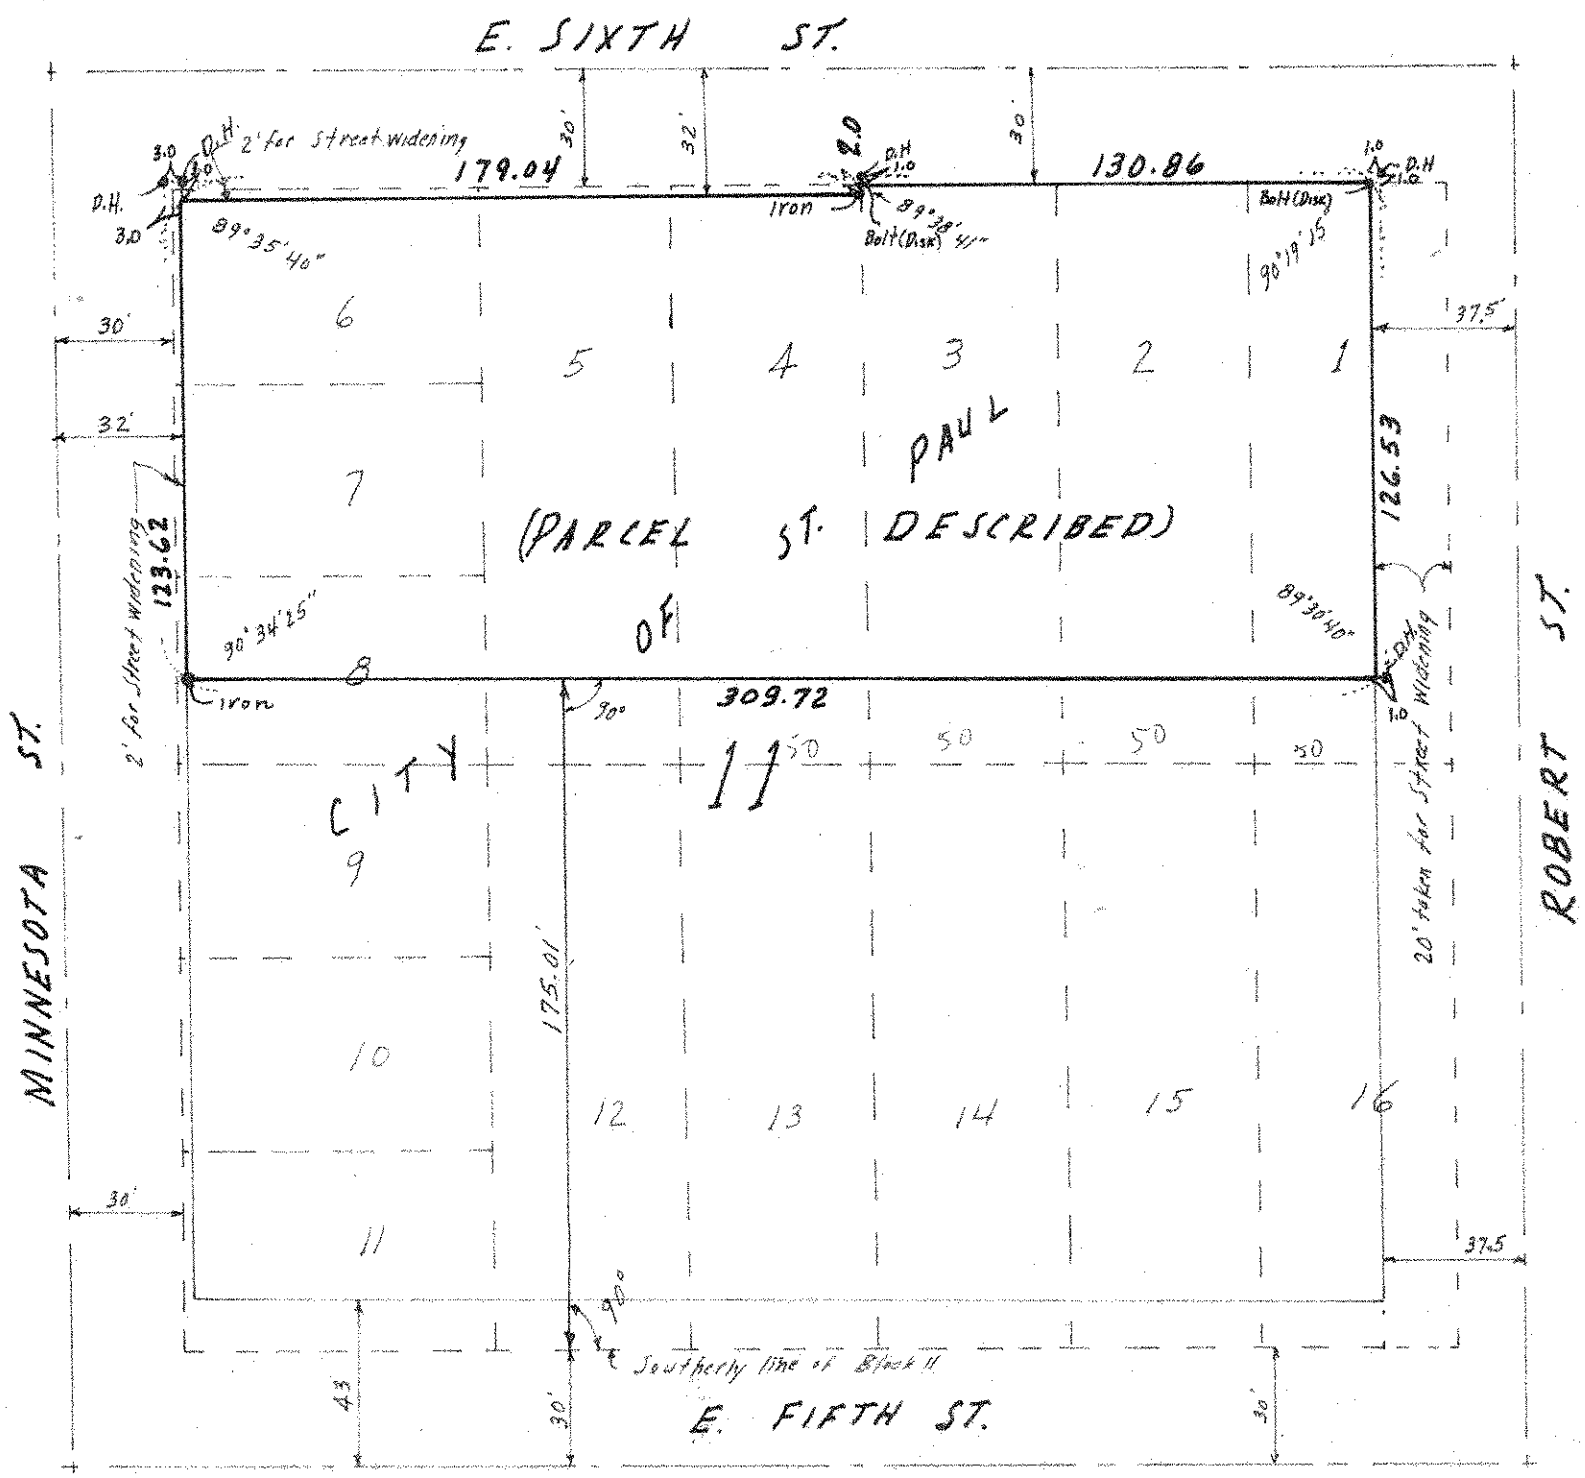
o D.H. - Denotes Drill Hole in Concrete Walk.