


NORTH 1/3 OF LOTS 1, 2 & 3. BLK. 11.
ST PAUL PROPER.

JOHN B. IRVINE SURVEYOR.
ROOM 508 GLOBE BLDG.
ST PAUL MINN.

SCALE 1 IN. = 20 FT.

JULY 17-05

E. SIXTH ST.

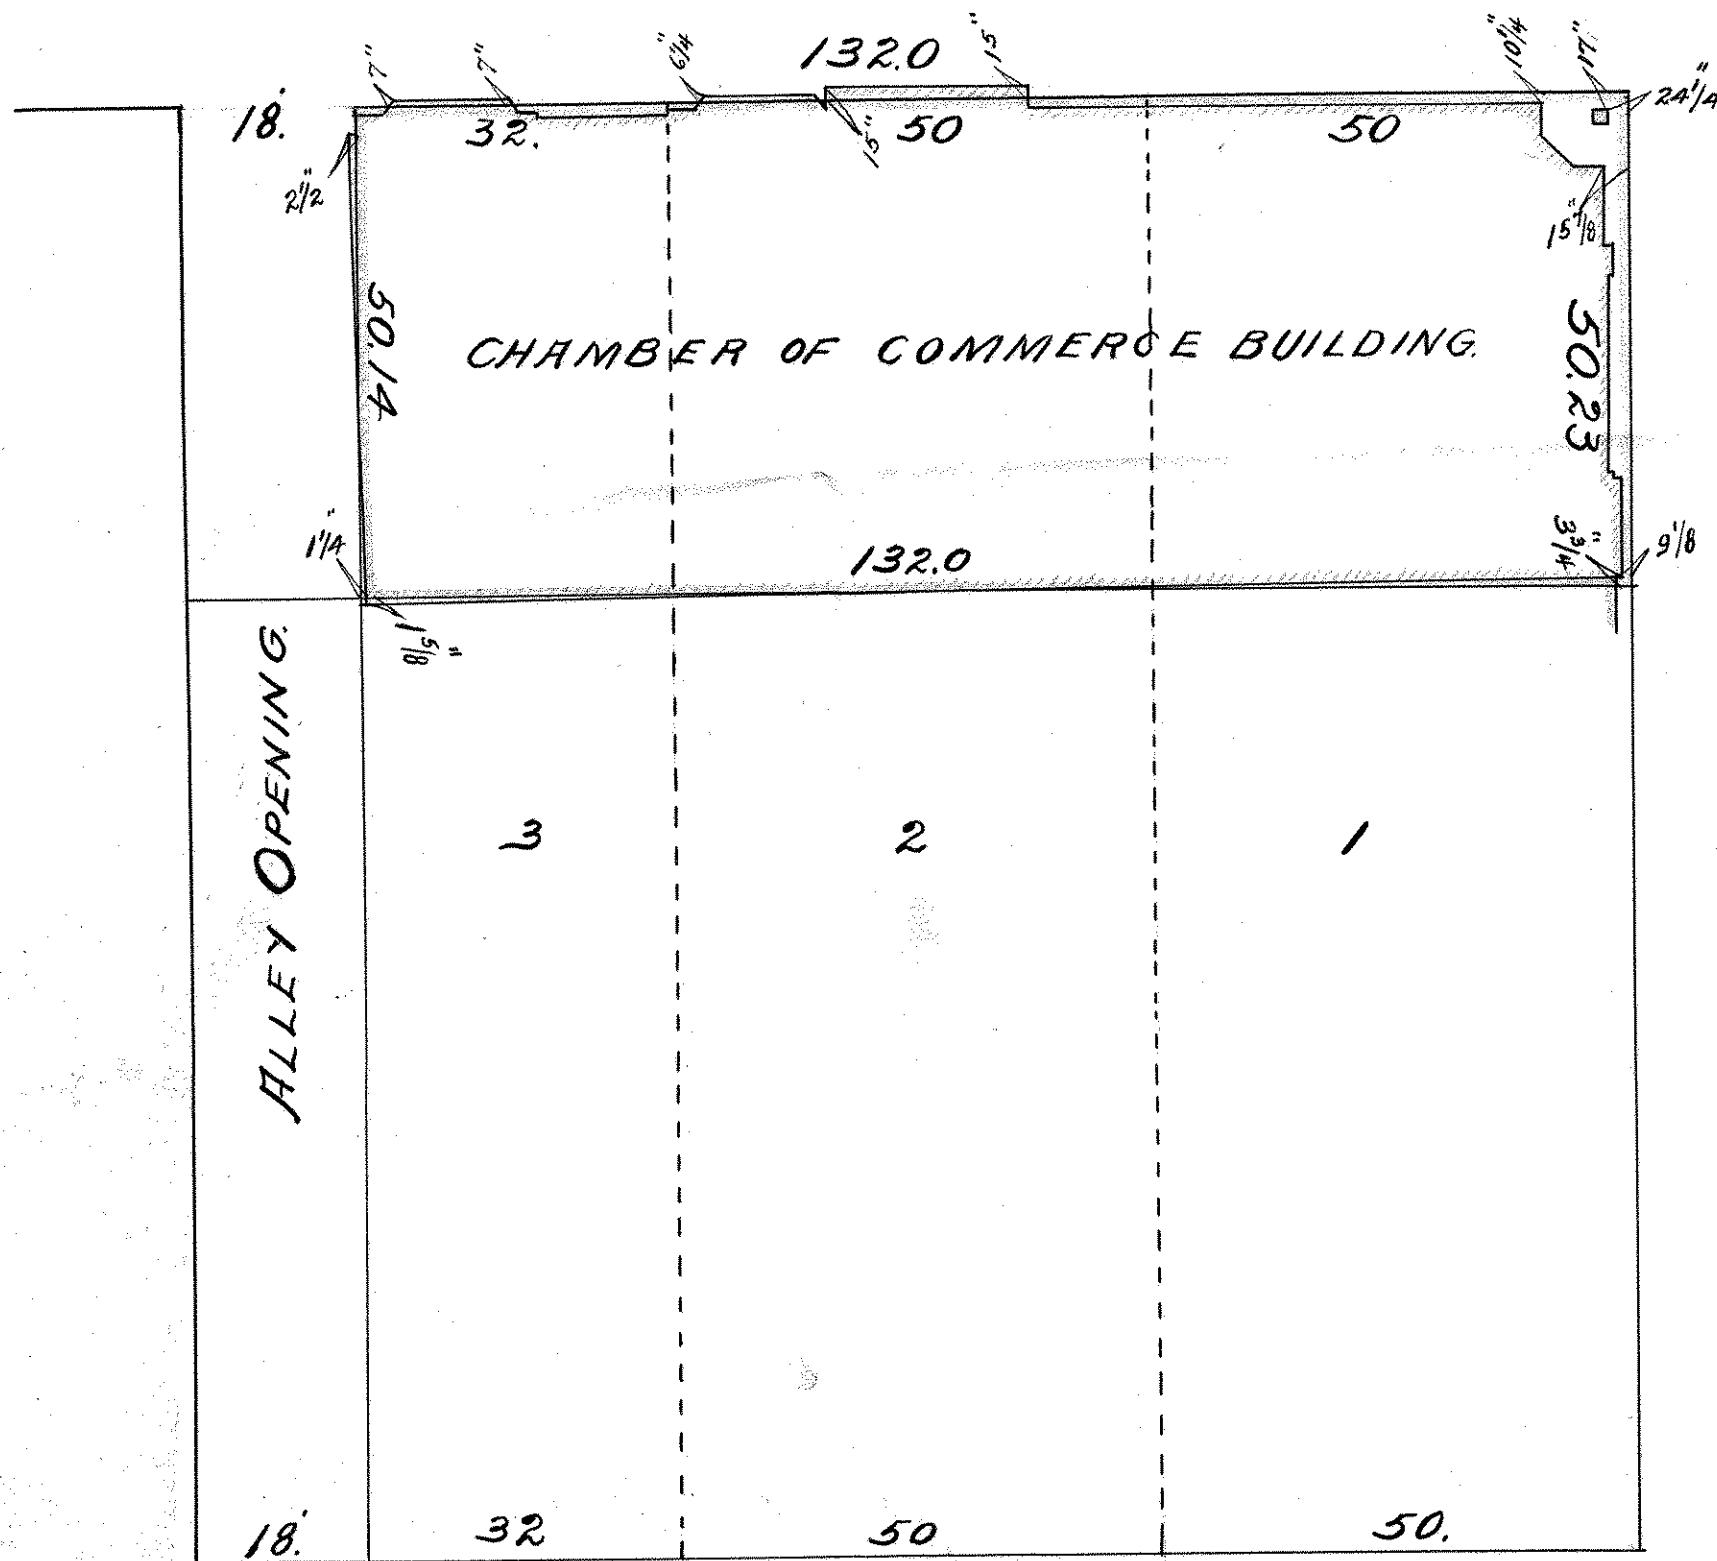

ROBERT ST.

ALLEY OPENING.