

E. SIXTH STREET

ROBERT STREET



ROBERT STREET

E. FIFTH STREET

STREET

JACKSON STREET

DESCRIPTION:
Lots 1 and 3, Block 1, Capital Centre No. 1
Ramsey County, MN.

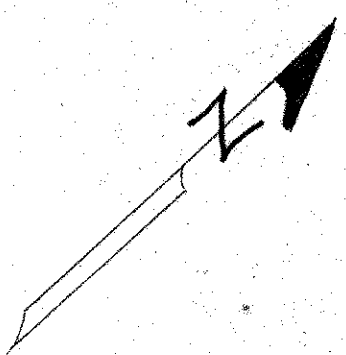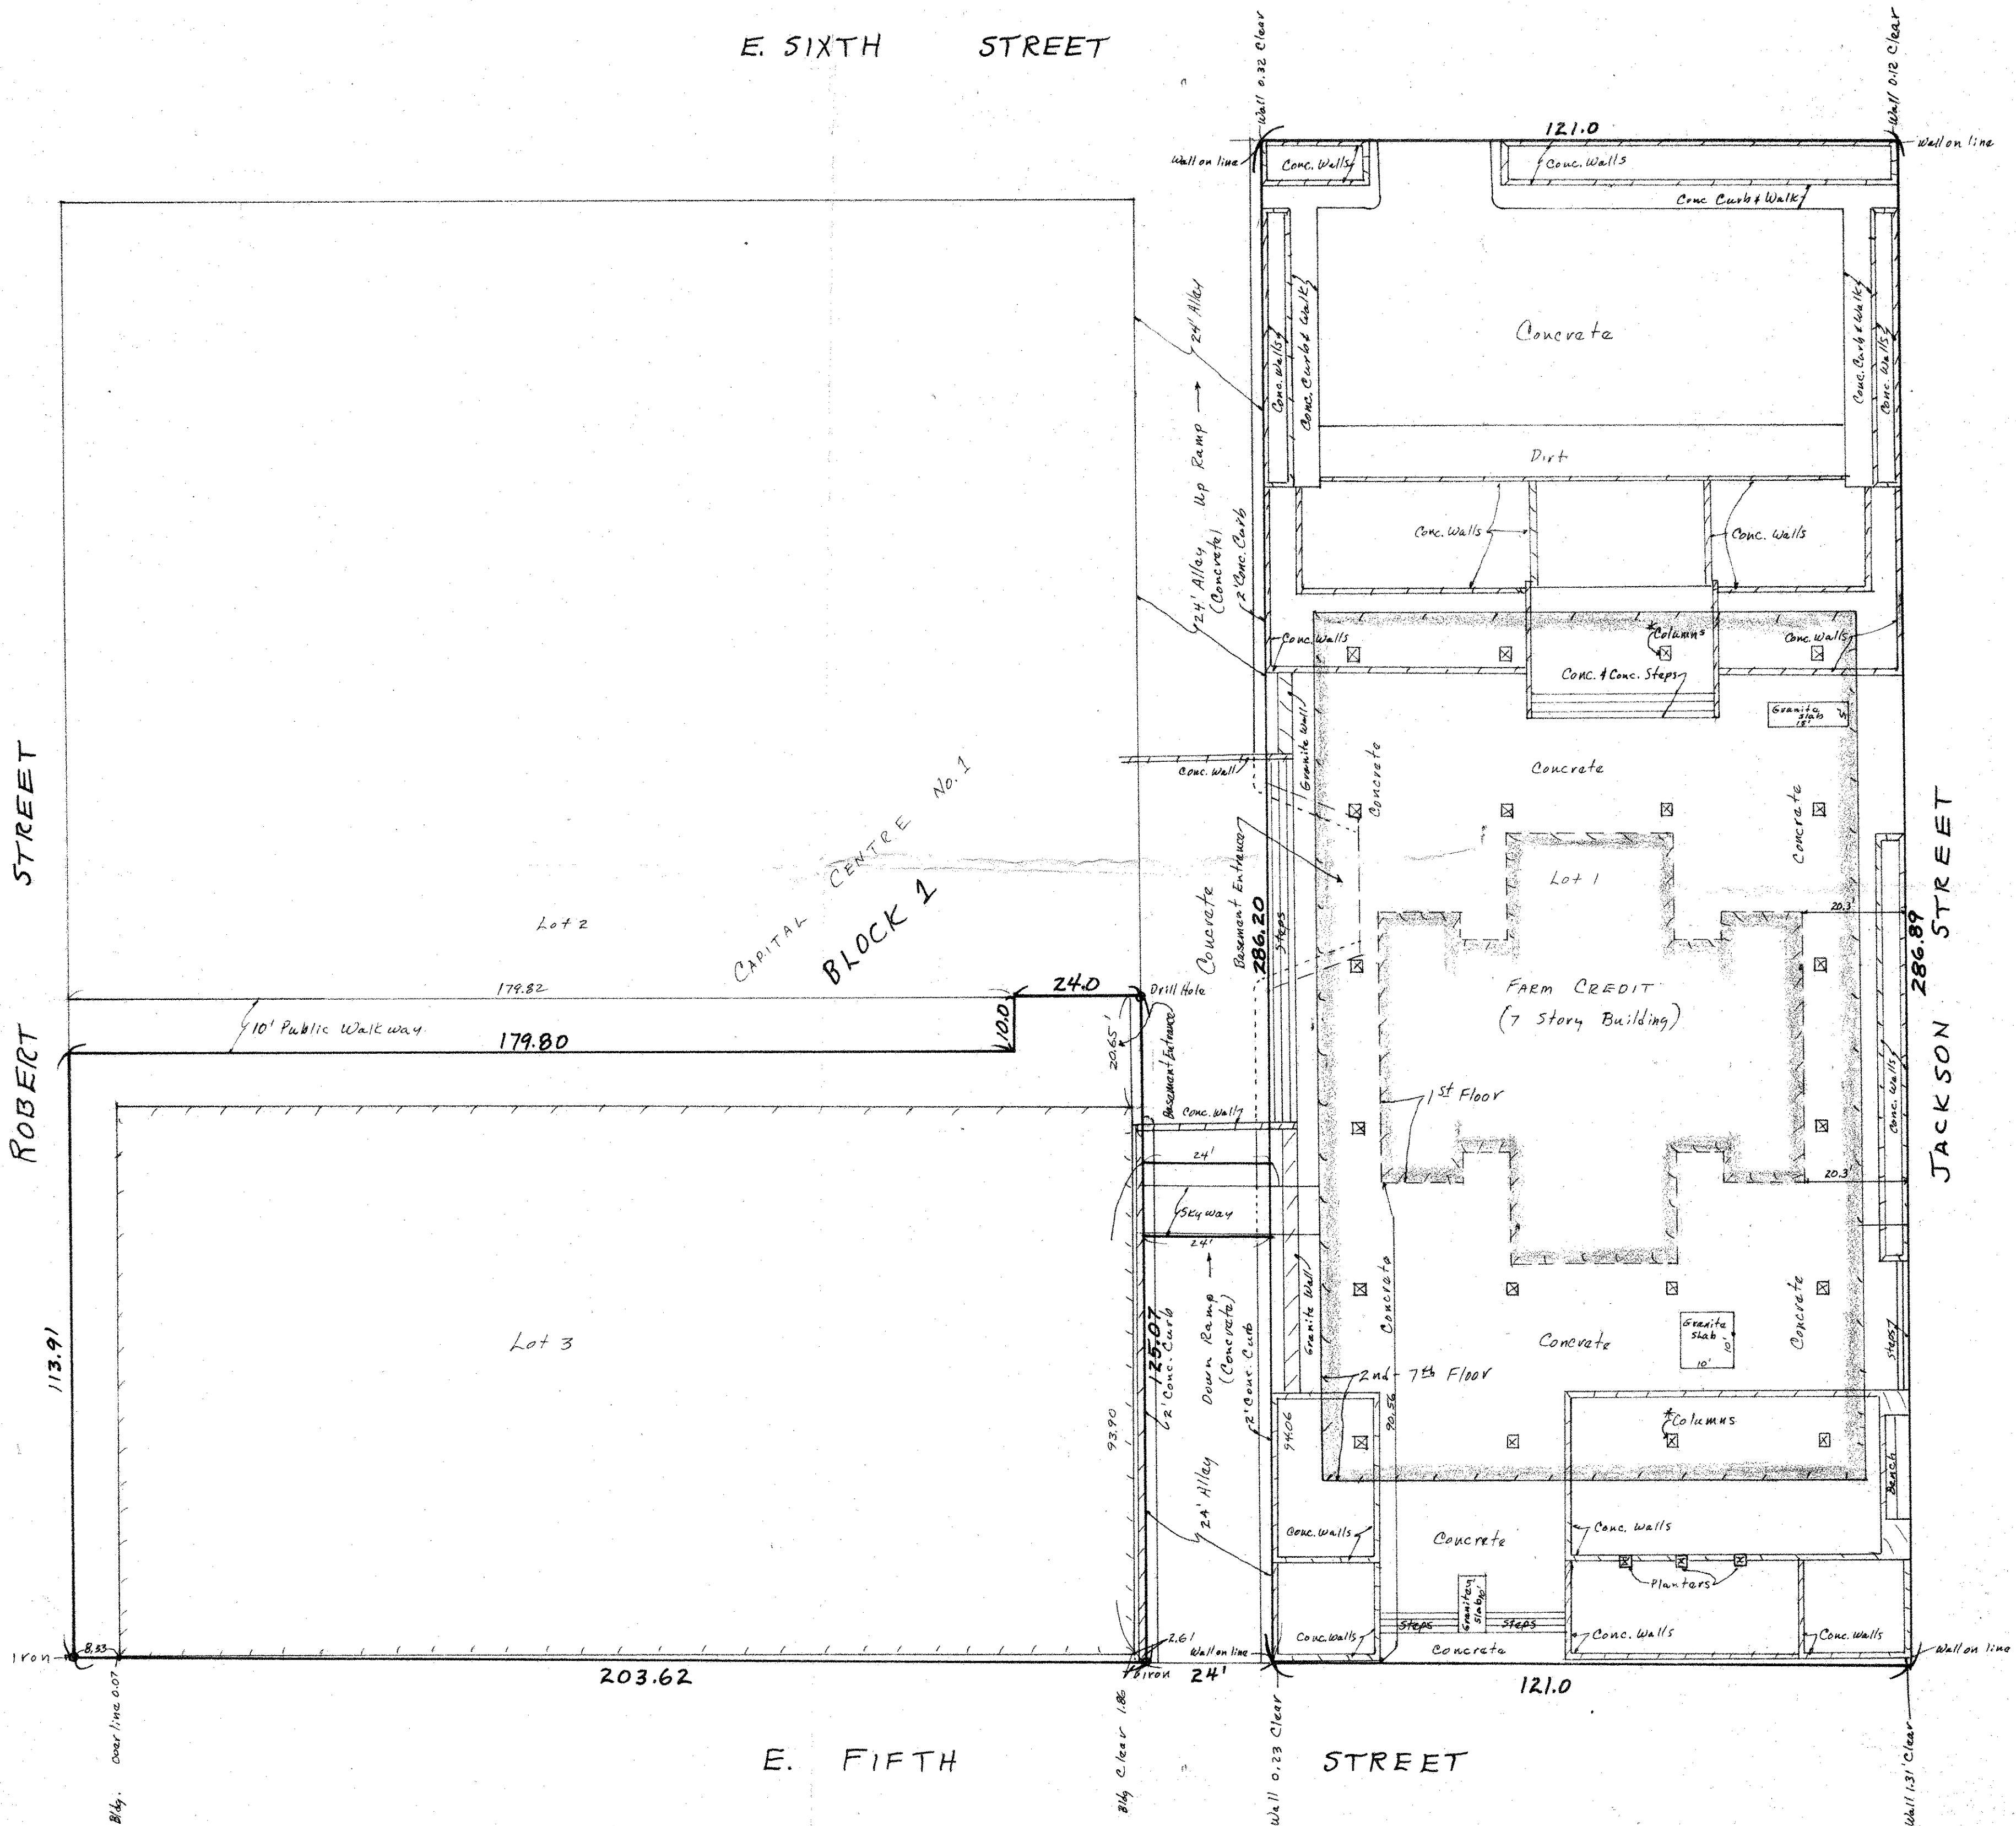

SCALE: 1"=20'

SITE MAP
FARM CREDIT
 ST. PAUL, RAMSEY CO., MN.
 Block 1, Capital Centre

GEORGI-SCHMIDT & ASSOC. INC.
 Land Surveyors
 3092 N. Lexington Ave. 483-4408
 ROSEVILLE, MINNESOTA 55113

November 1980