

# LOT 12 BLOCK 12

EXCEPT ALLEY

## ST. PAUL PROPER.


JOHN B. IRVINE. SURVEYOR.

416 GLOBE BLDG.

ST. PAUL MINN.

FEB. 13-07.

SCALE 10ft. per inch.

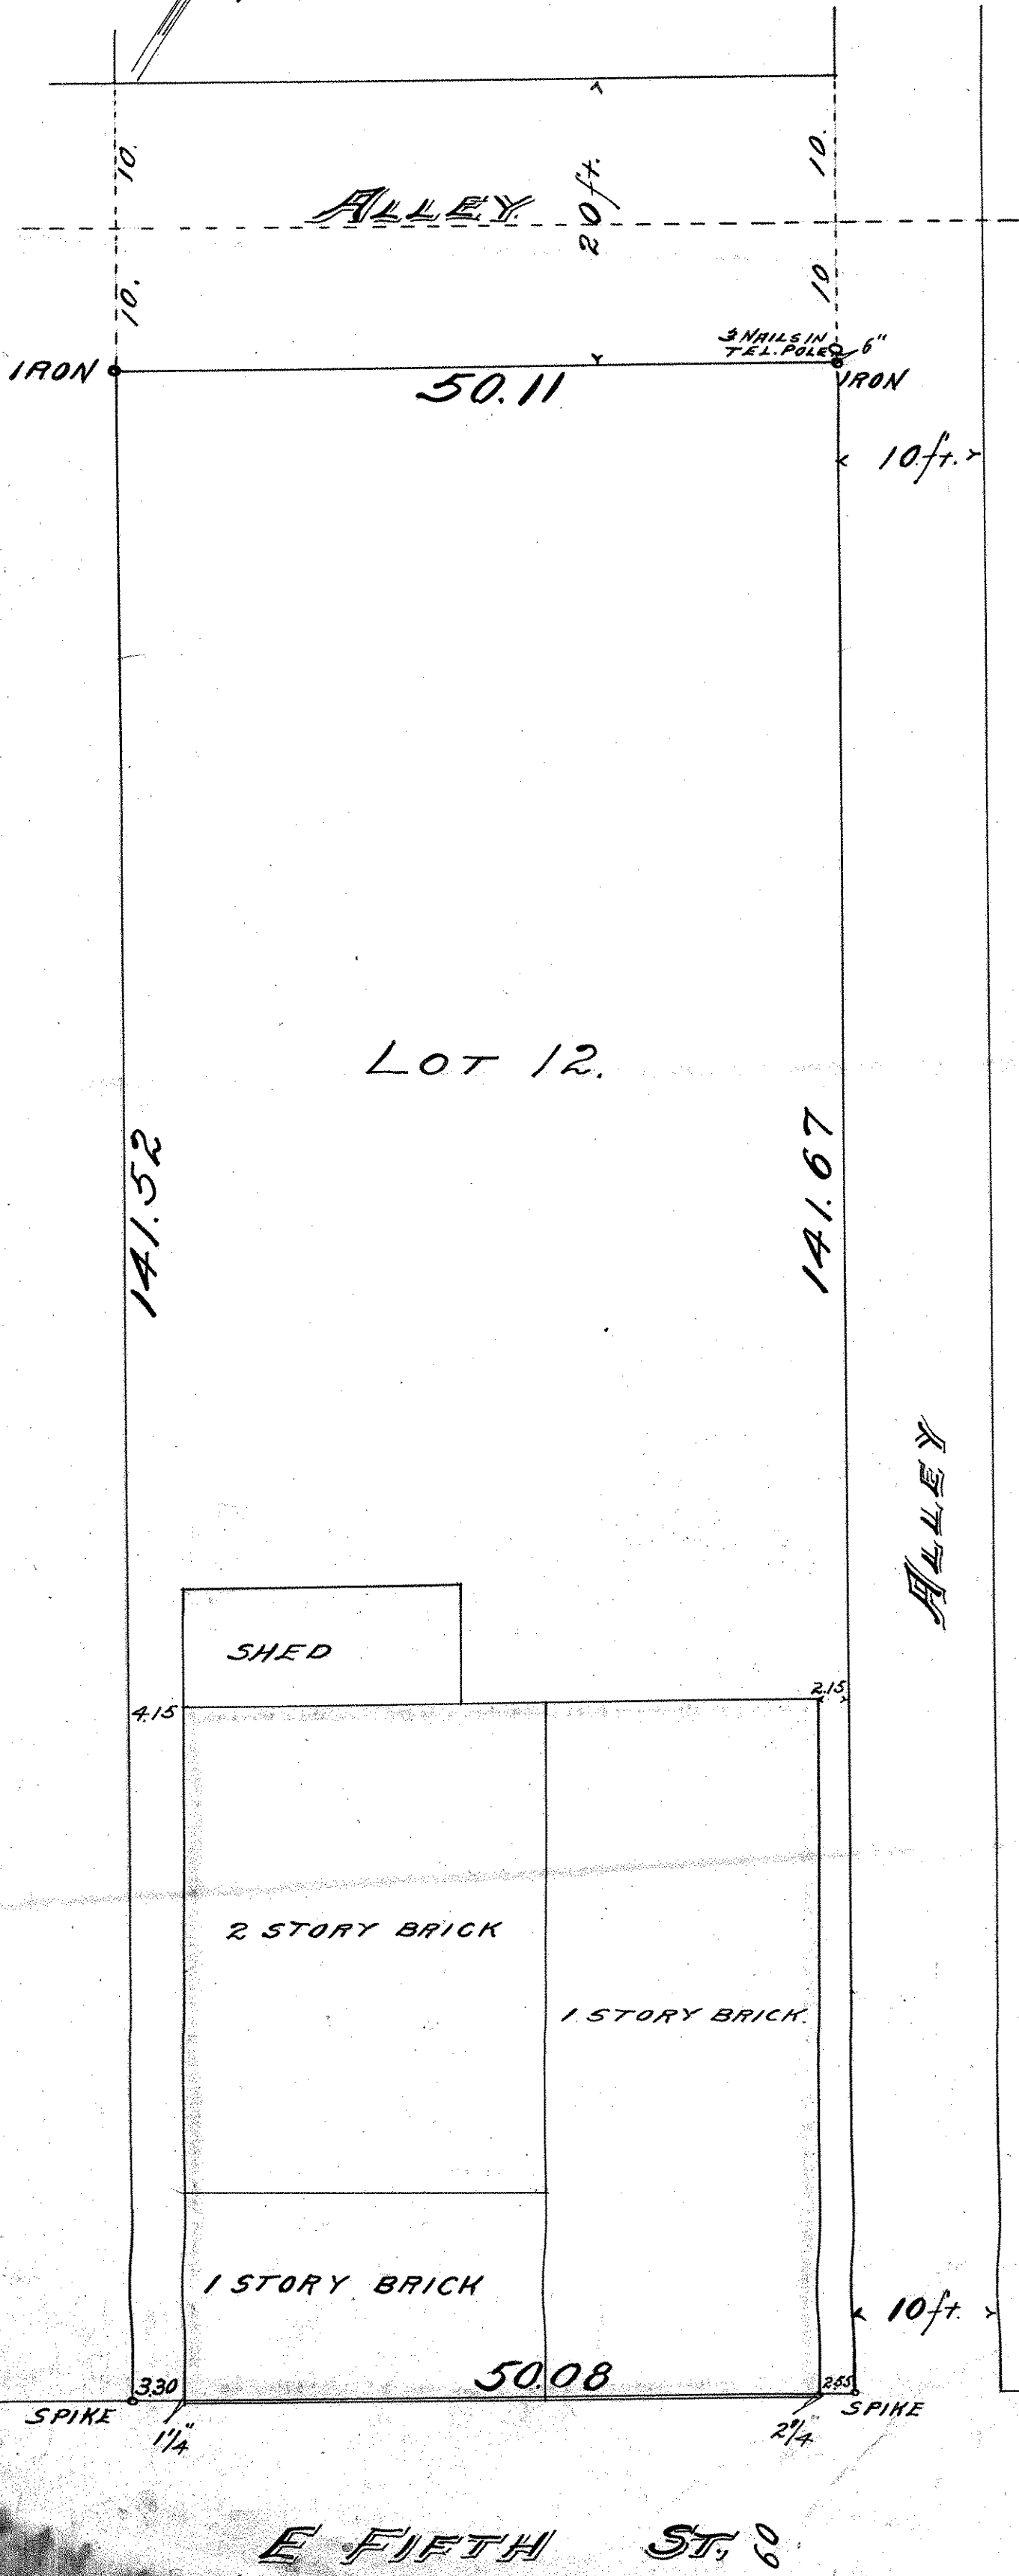

LOT 12.

141.52

141.67

ALLEY

SHED

4.15

2 STORY BRICK

2.15

1 STORY BRICK.

1 STORY BRICK

10ft.

50.08

3.30

SPIKE

1 1/4"

2.55

SPIKE

2 1/4"

E FIFTH ST. S