FROM THE OFFICE OF

CHARLES O. GEORGI COMPANY

2215 West County Road B — Saint Paul 8, Minnesota

MINNESOTA REGISTERED LAND SURVEYOR

Certificate of Survey

I Hereby Certify that this plat shows a survey made by me of the property described on this plat, and that the corners are correctly placed as shown, and that all locations, encroachments, etc., have been correctly shown.

Frank Graham Attorney

Surveyed For FIRST NATIONAL BANK

Date August 1969

Scale 1" = 50'

By Charles O. Georgi

REGISTERED LAND SURVEYOR

Description:

Lot 1, Block 18, City of St Paul (St. Paul Proper) except the Easterly 20 feet taken for widening of Robert St.,
Lots 2, 3, 4, 5, 6 and 7, Block 18, City of St Paul (ST Paul Proper);
Lots 14 and 15, Block 18, City of St. Paul (St. Paul Proper) except the Southerly two-thirds thereof;
Lot 16, Block 18, City of St Paul (St Paul Proper) except the Southerly two-third thereof and except the Easterly 20 feet taken for widening of Robert St.
Lots A and B, The First National Plat, a rearrangement of part of Block 18, St. Paul Proper.

Surveyors Note:

Since the distances vary from the old "City of St Paul" plat, Robert St. was widened etc, it is recommended that a new plat be made and filed to delineate this entire block.

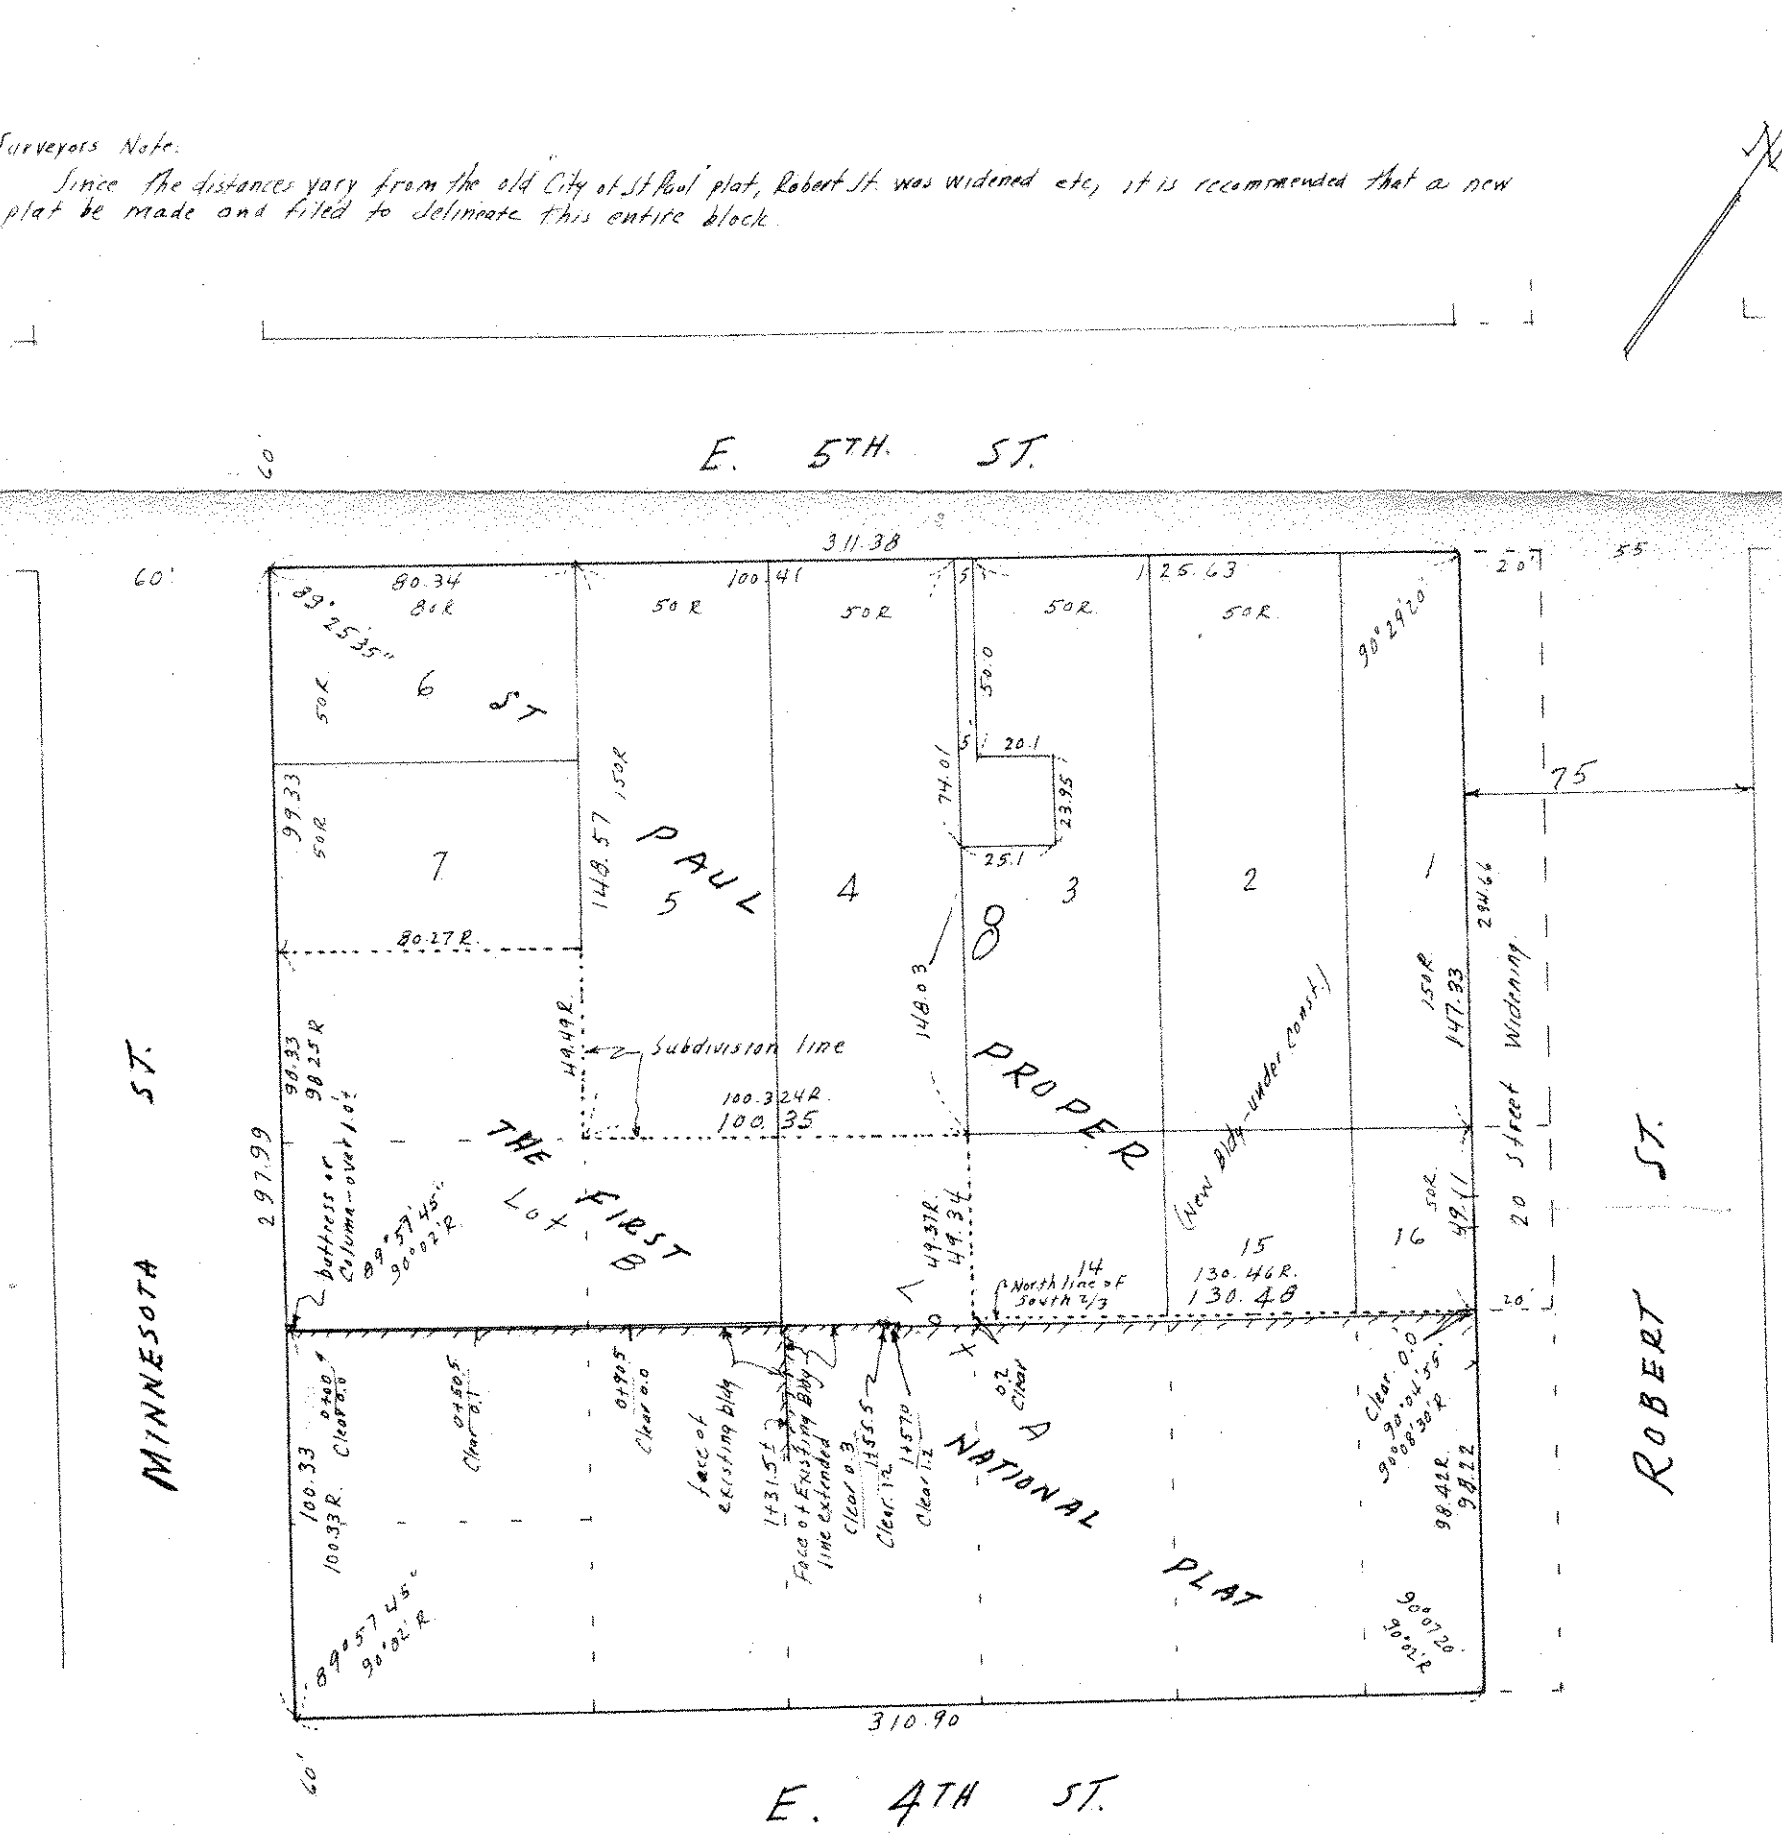

Note:

The North face of existing building are as shown, however irregular wall faces from removing old buildings make it difficult to determine with precision.

R denotes Record plat distances.