

CHARLES O. GEORGI COMPANY

2215 West County Road B

Saint Paul 8, Minnesota

MINNESOTA REGISTERED LAND SURVEYOR

Certificate of Survey

I Hereby Certify that this plat shows a survey made by me of the property described on this plat, and that the corners are correctly placed as shown, and that all locations, encroachments, etc., have been correctly shown.

FIRST NATIONAL BANK OF ST. PAUL



Surveyed For Housing And Redevelopment Authority

Date January 1972

Scale 1" = 30'

By Charles O. Georgi
REGISTERED LAND SURVEYOR

DESCRIPTION:
See Attached Sheets

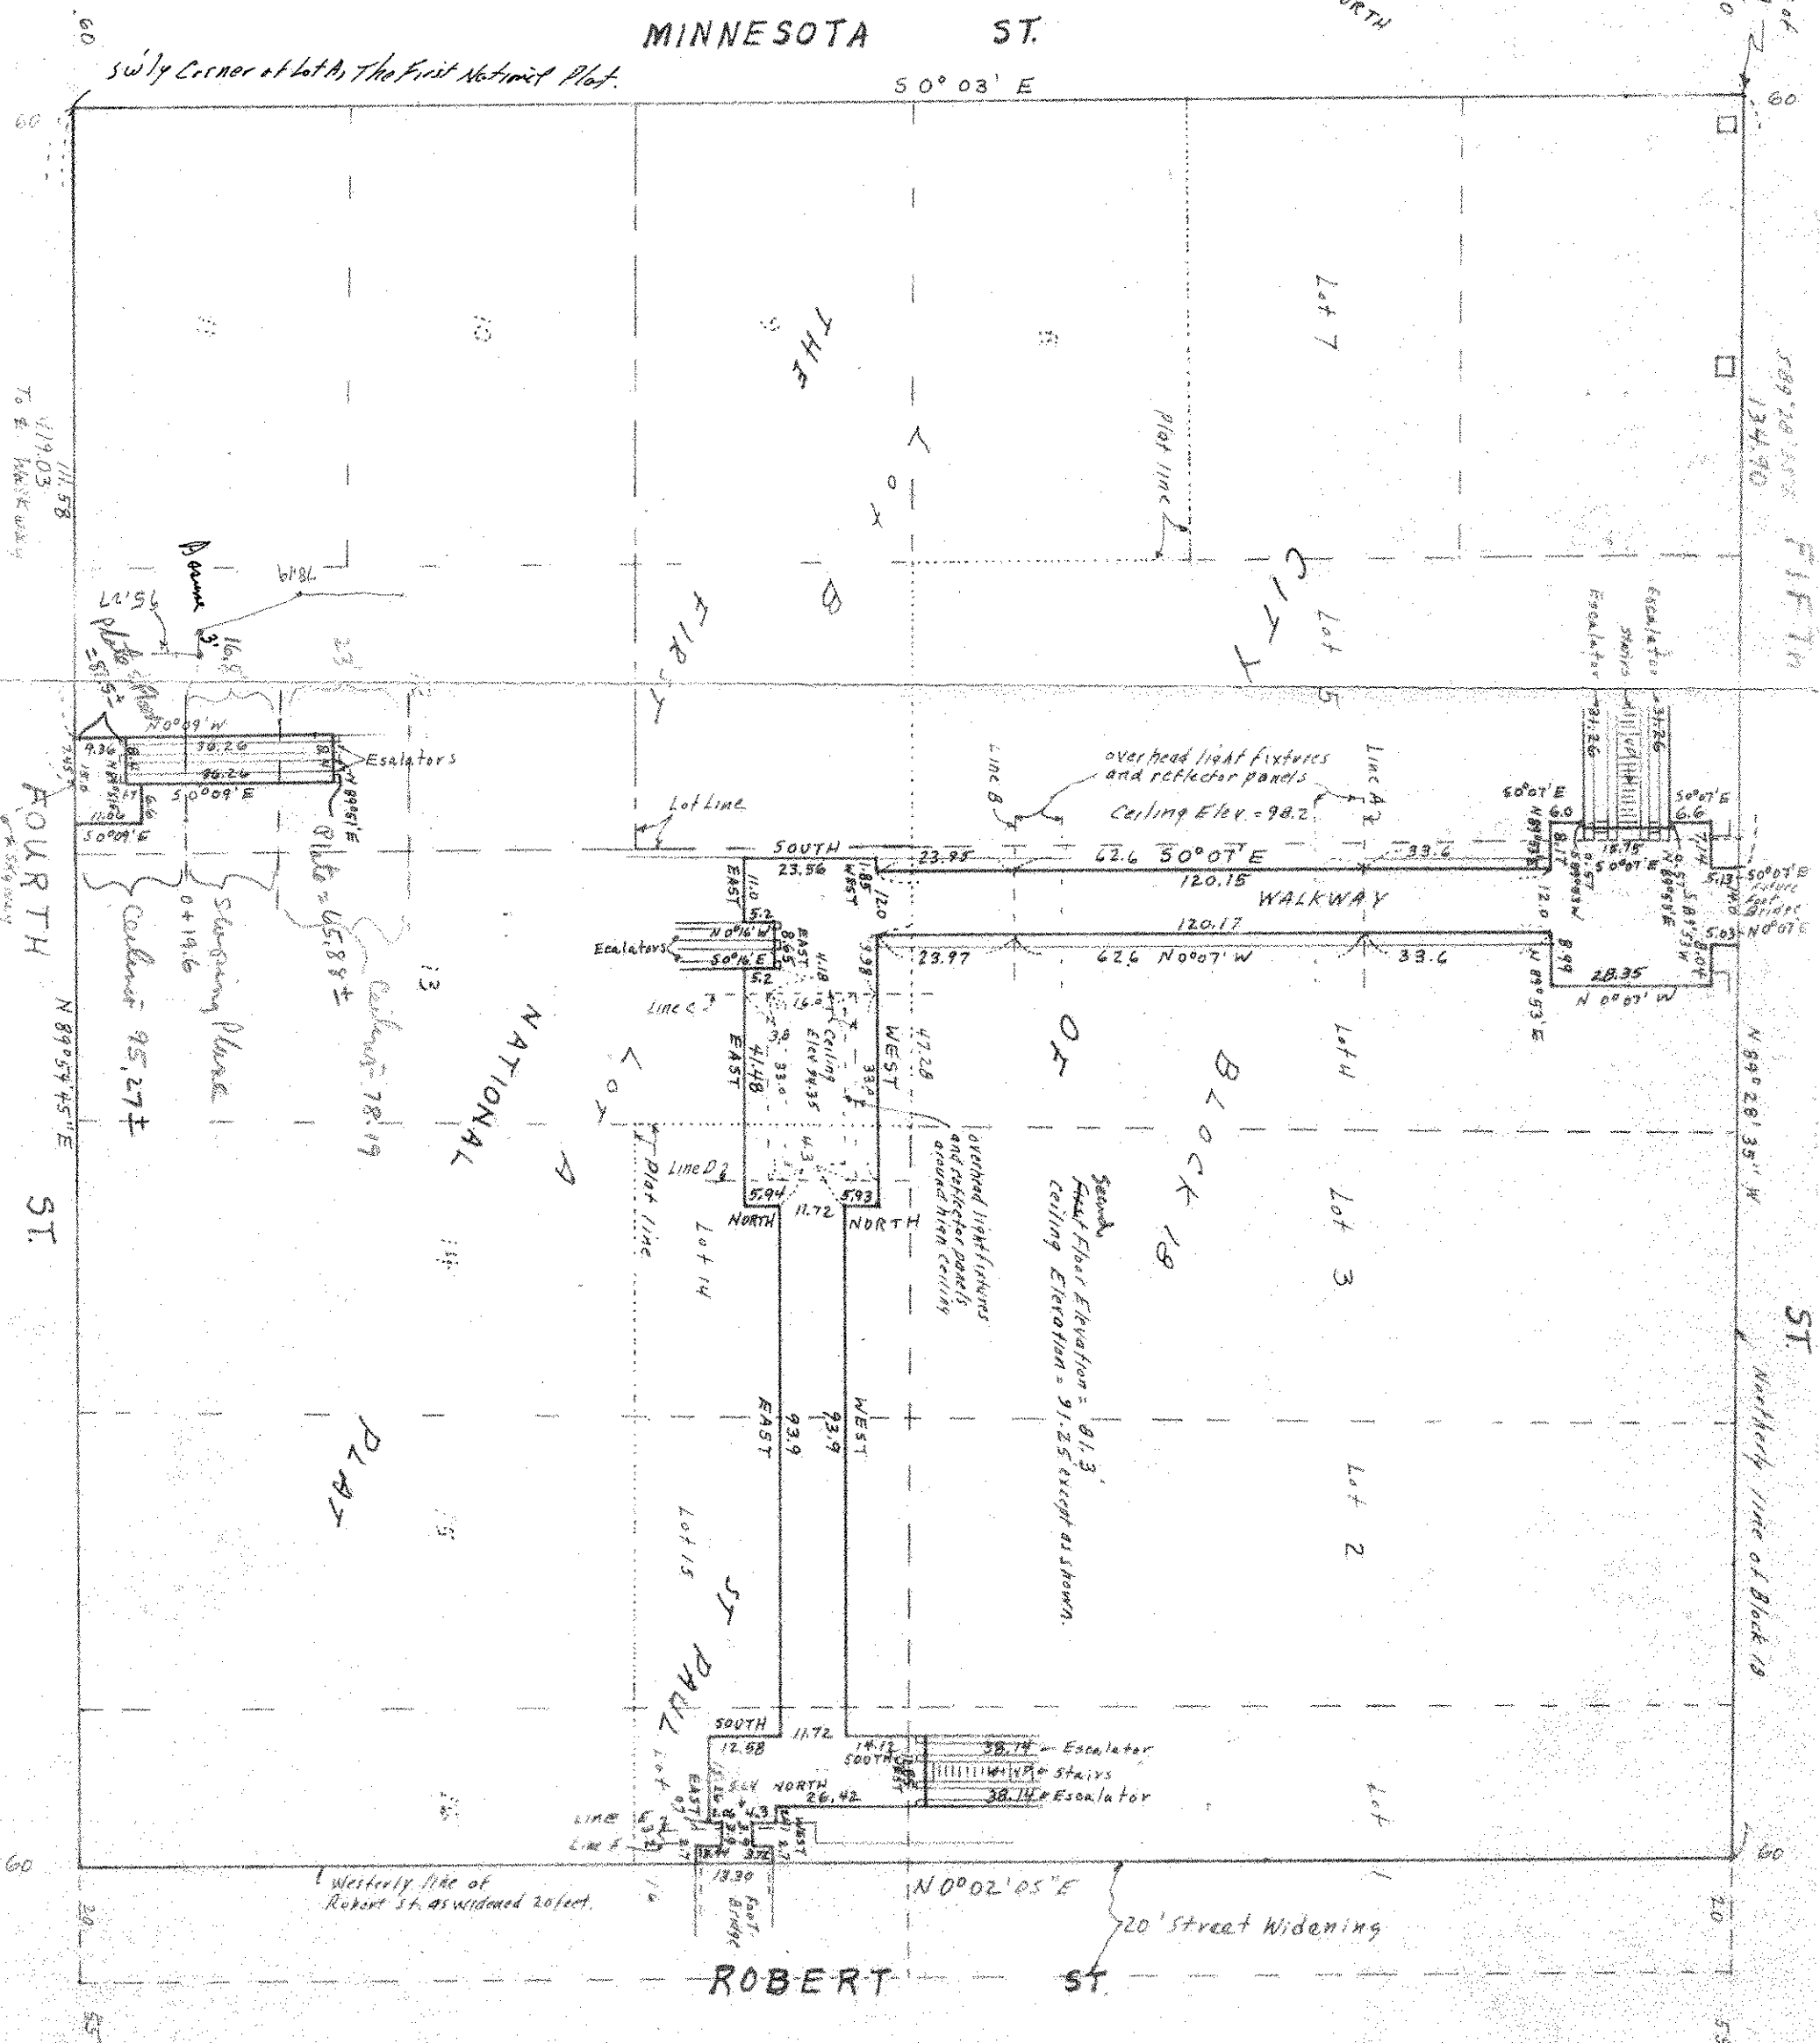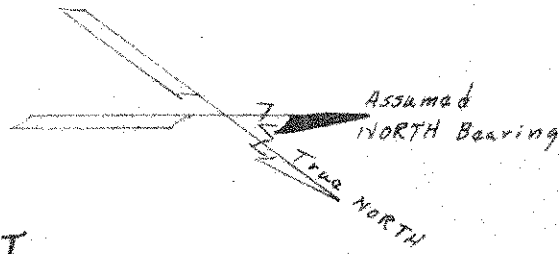

71.58
419.03

FOURTH ST.
N 89° 57' 45" E

60
20
55

NW 1/4 corner of Block 18
589' 10" W
134' 90"
FIFTH ST.
N 89° 28' 35" W
N 89° 07' W
N 89° 07' W
20' Street Widening

Westerly line of Robert St. as widened 20 feet.

Ceiling Elevation = 91.25' except as shown.

overhead light fixtures and reflector panels
Ceiling Elev. = 98.2'

overhead light fixtures and reflector panels around high ceiling

ROBERT ST

MINNESOTA ST.
50° 03' E

SW 1/4 corner of lot A, The First National Plat.

PLAT

FIRST CITY

OK BLOCK 18

THE

Lot 7

Lot 5

Lot 4

Lot 3

Lot 2

Lot 1

NATIONAL A

ST PAUL

LOT 15

LOT 14
















