


NORTH 1/2 OF LOT 9 BLOCK 18
ST. PAUL PROPER.

scale 10 feet per inch

surveyed March 29th 1902.

MINNESOTA 60 ST.

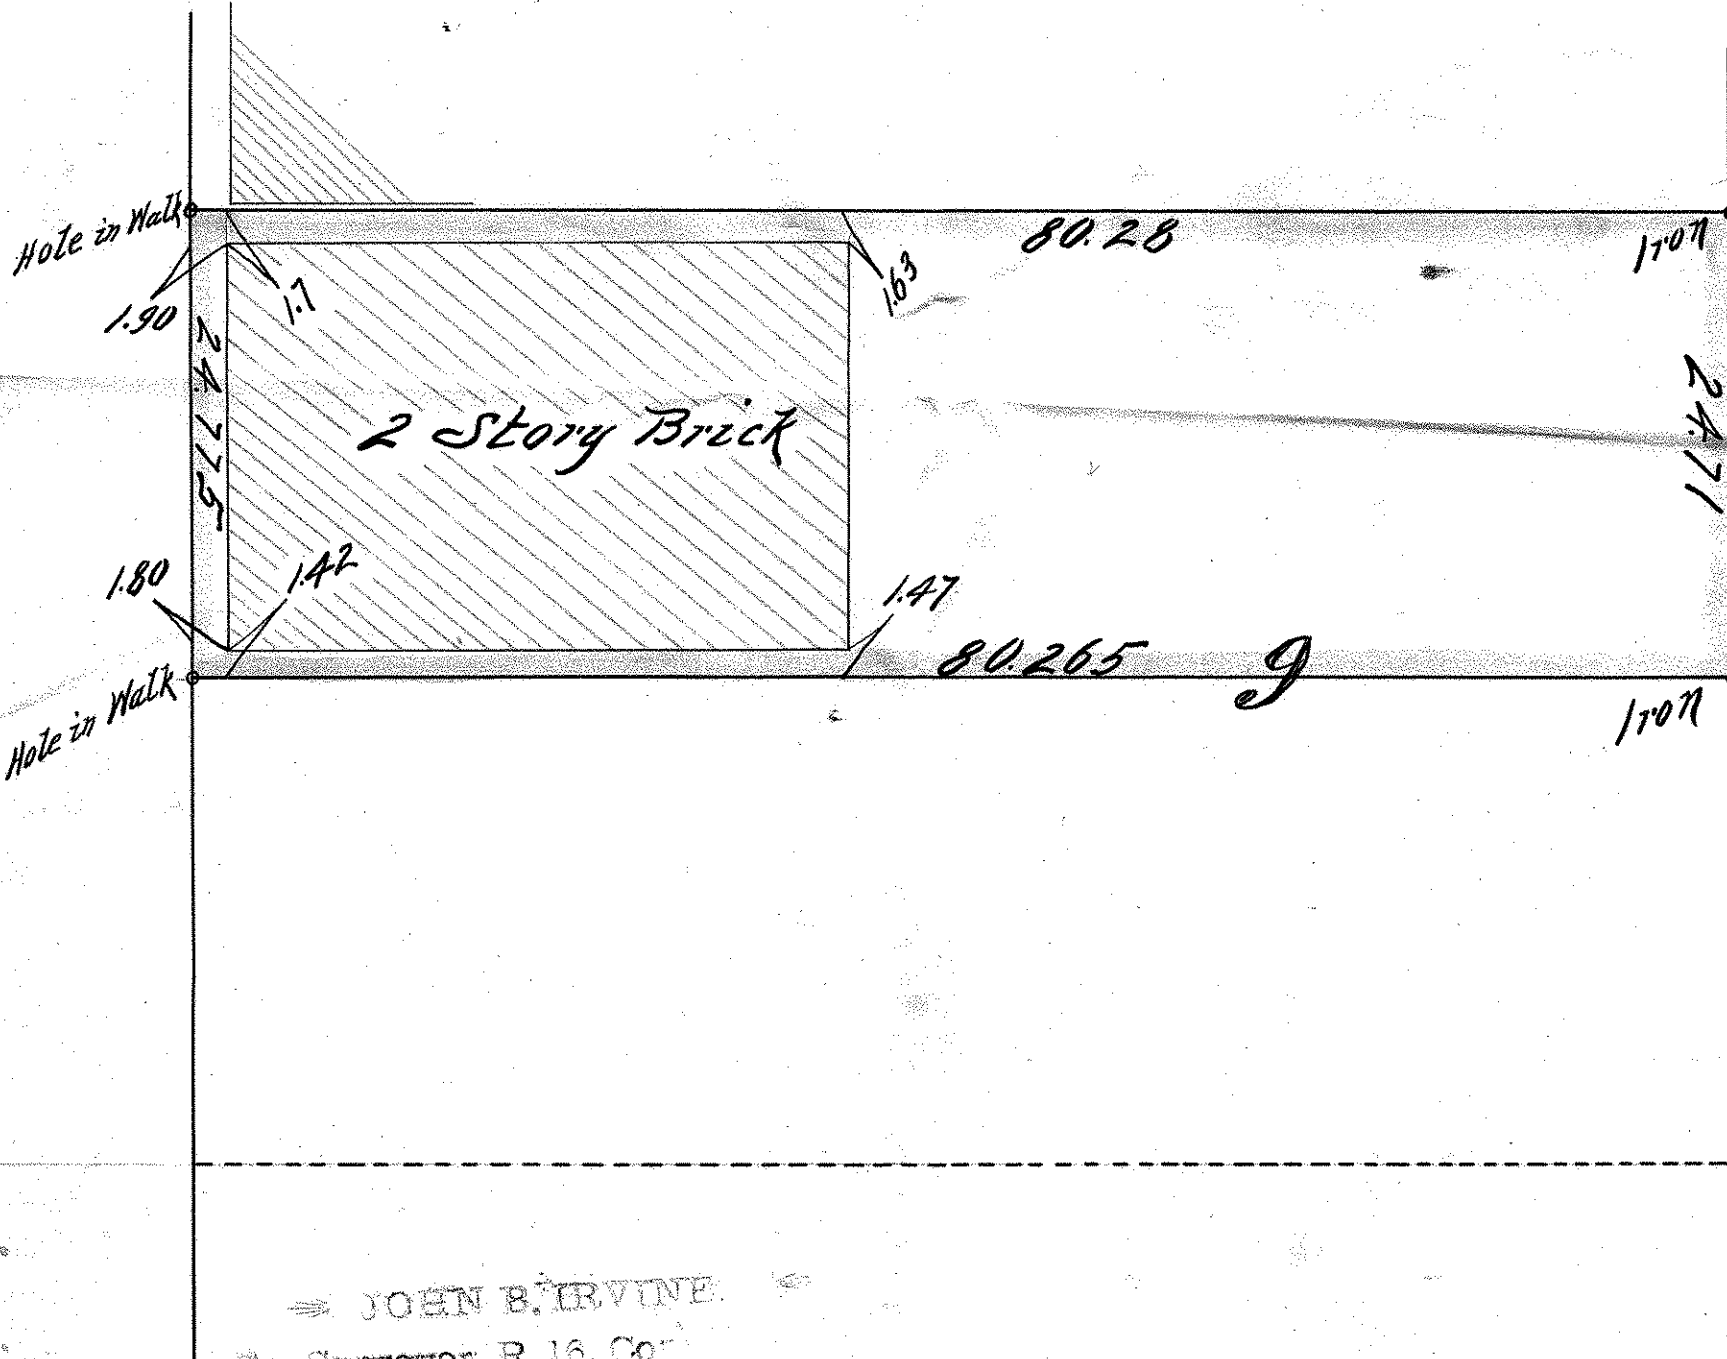

JOHN B. IRVINE
Co. Surveyor, R. 16. Cor.