


LOTS 8 & 10 BLOCK 18
ST. PAUL PROPER.

St.

60.

MINNESOTA

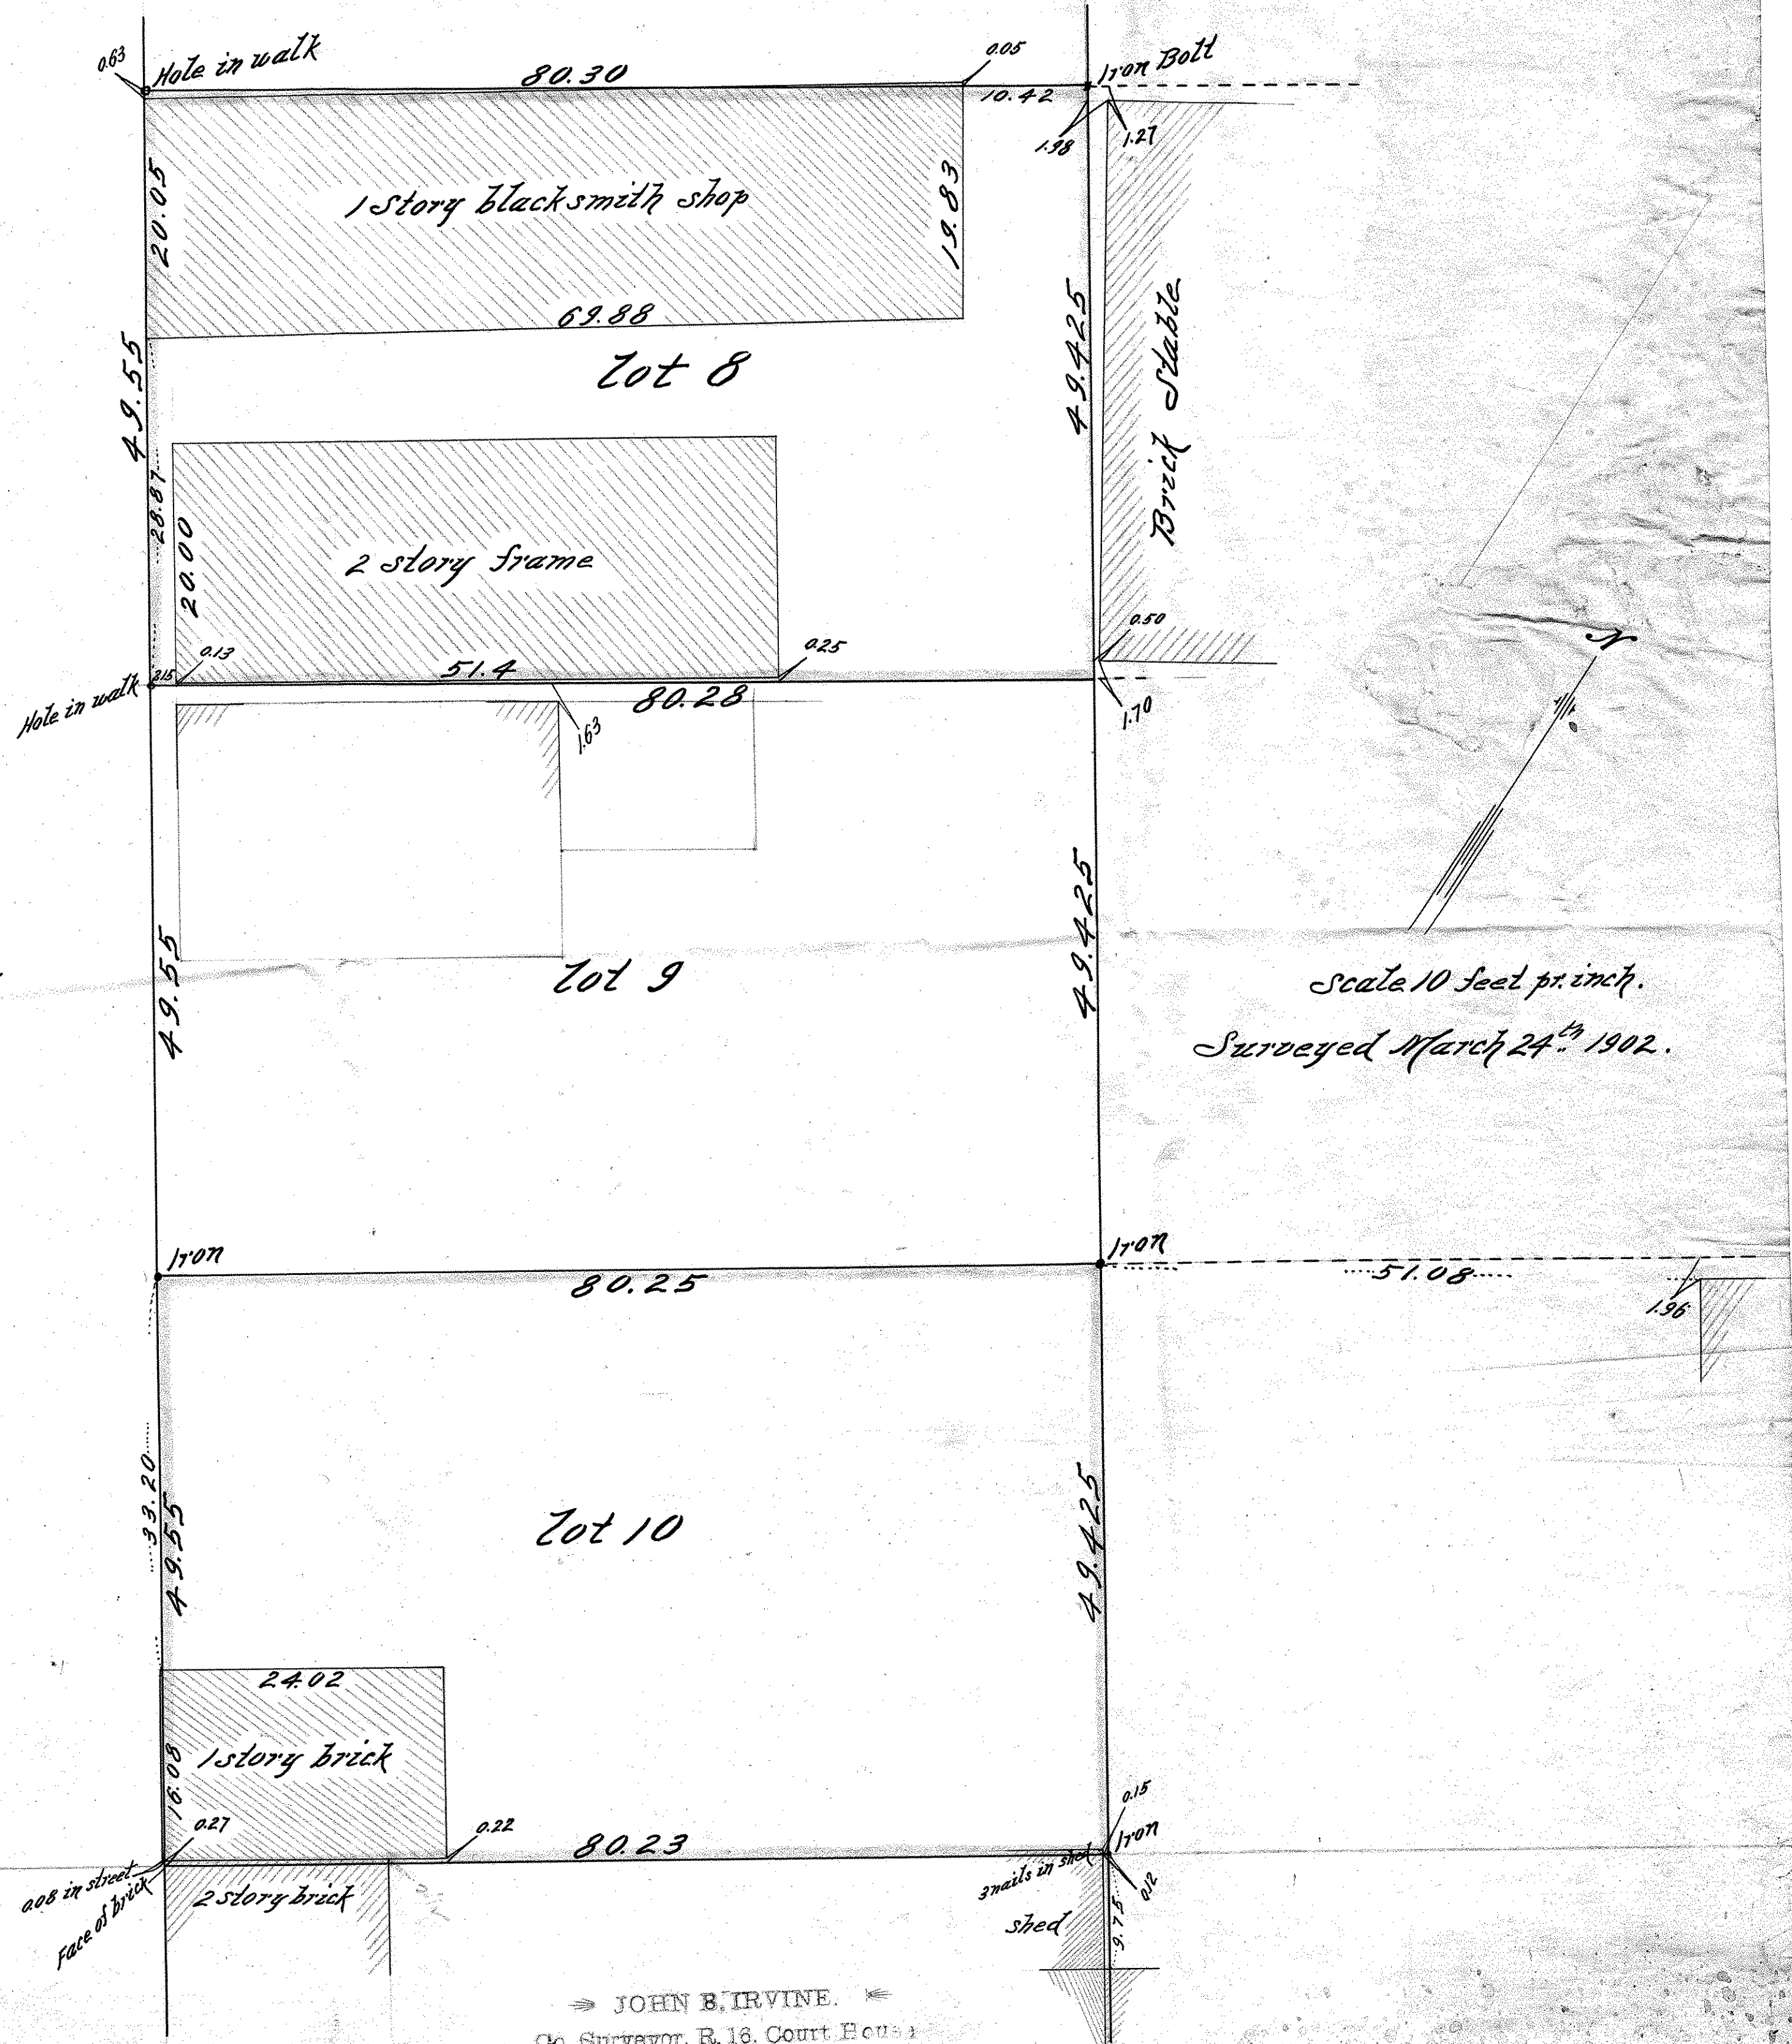

JOHN B. IRVINE.
Co. Surveyor, R. 16, Court House