

№ LOTS 5 & 6 BLOCK 20.

ROBERT & RANDALL'S ADD.

JOHN B. IRVINE, SURVEYOR.

408 GLOBE BLDG.


ST. PAUL, MINN.

MARCH 20-1911.

SCALE 10 ft. per inch.

100.14

EIGHTH ST.

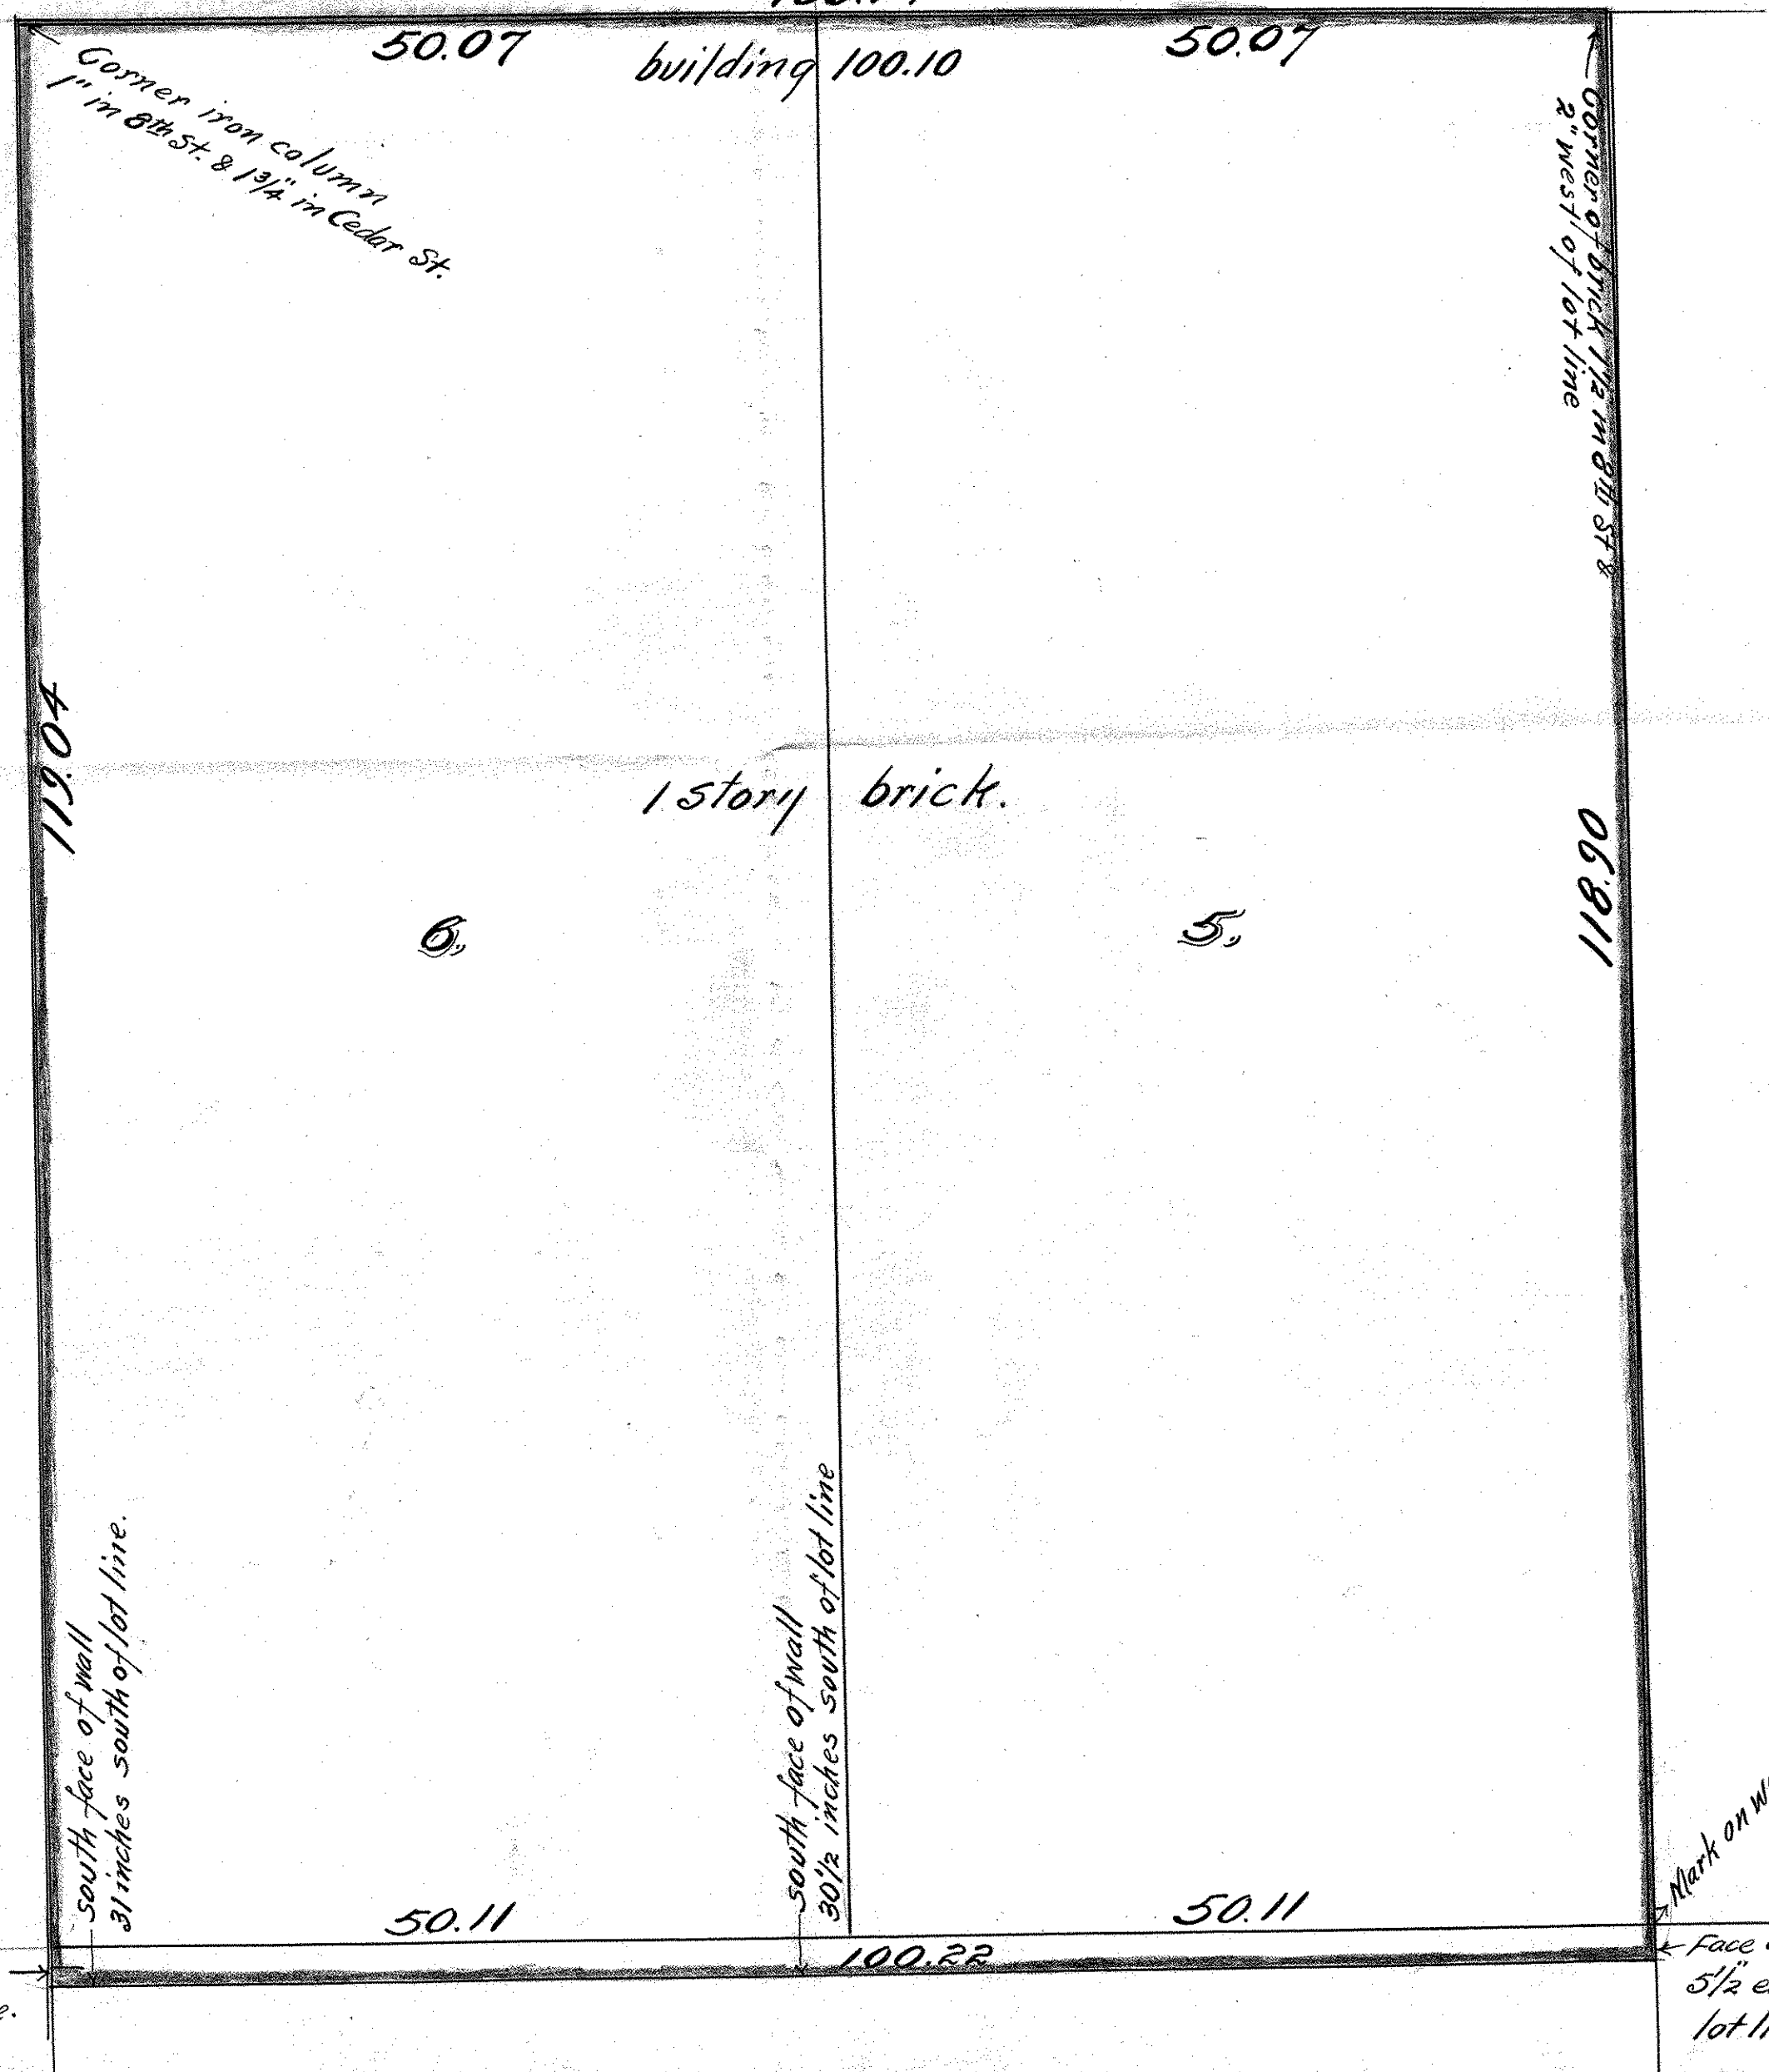

Corner iron column
1" in 8th St. & 1 3/4" in Cedar St.

Corner of brick 1 1/2 in 8th St. &
2" west of lot line

CEDAR ST.

119.04

50.07

building 100.10

50.07

1 story brick.

6.

5.

118.90

South face of wall
31 inches south of lot line.

South face of wall
30 1/2 inches south of lot line

50.11

100.22

50.11

Mark on wall.

Corner iron column
14 3/4" south of lot line.
2 3/8" in Cedar St.

Face of brick
5 1/2" east of
lot line.