


Fourth St.

St.

St. Peter

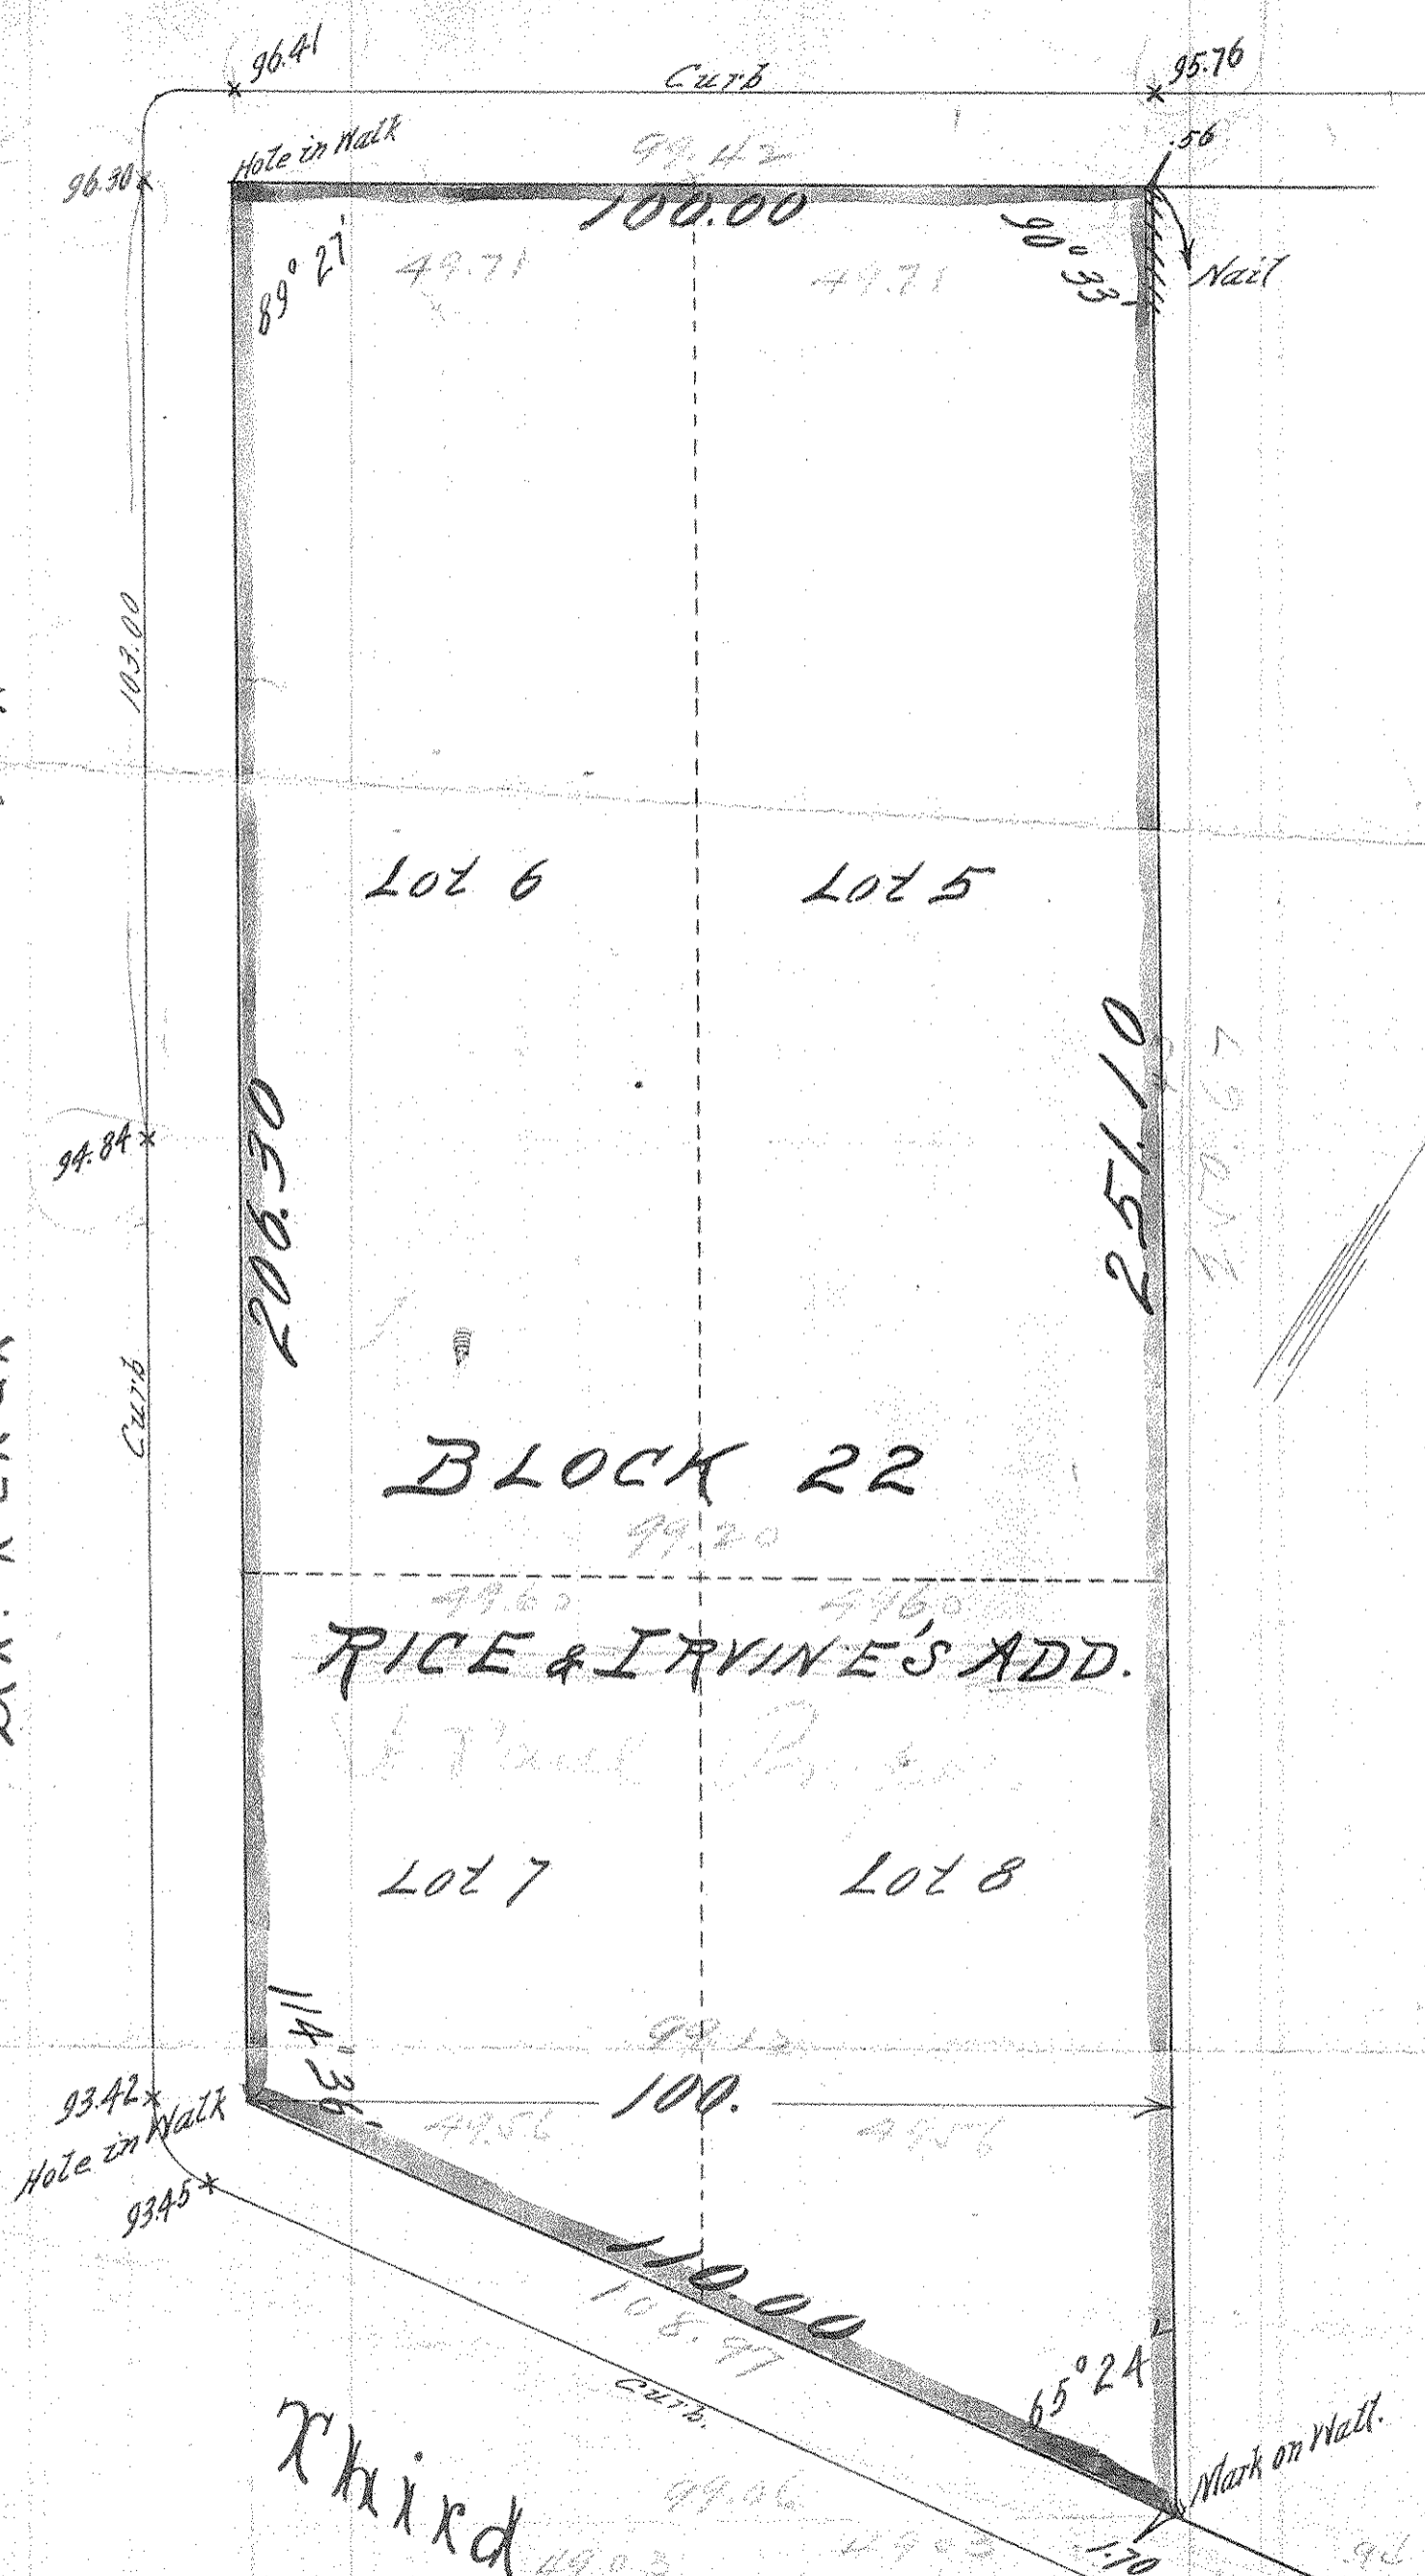

BLOCK 22

RICE & IRVINE'S ADD.

Lot 7

Lot 8

Lot 6

Lot 5

206.30

251.10

100.

110.00

Scale 20 ft. pr. inch

JOHN B. IRVINE
COUNTY SURVEYOR.

May 16th 1901

St.