


Fourth St.

St.

St. Peter

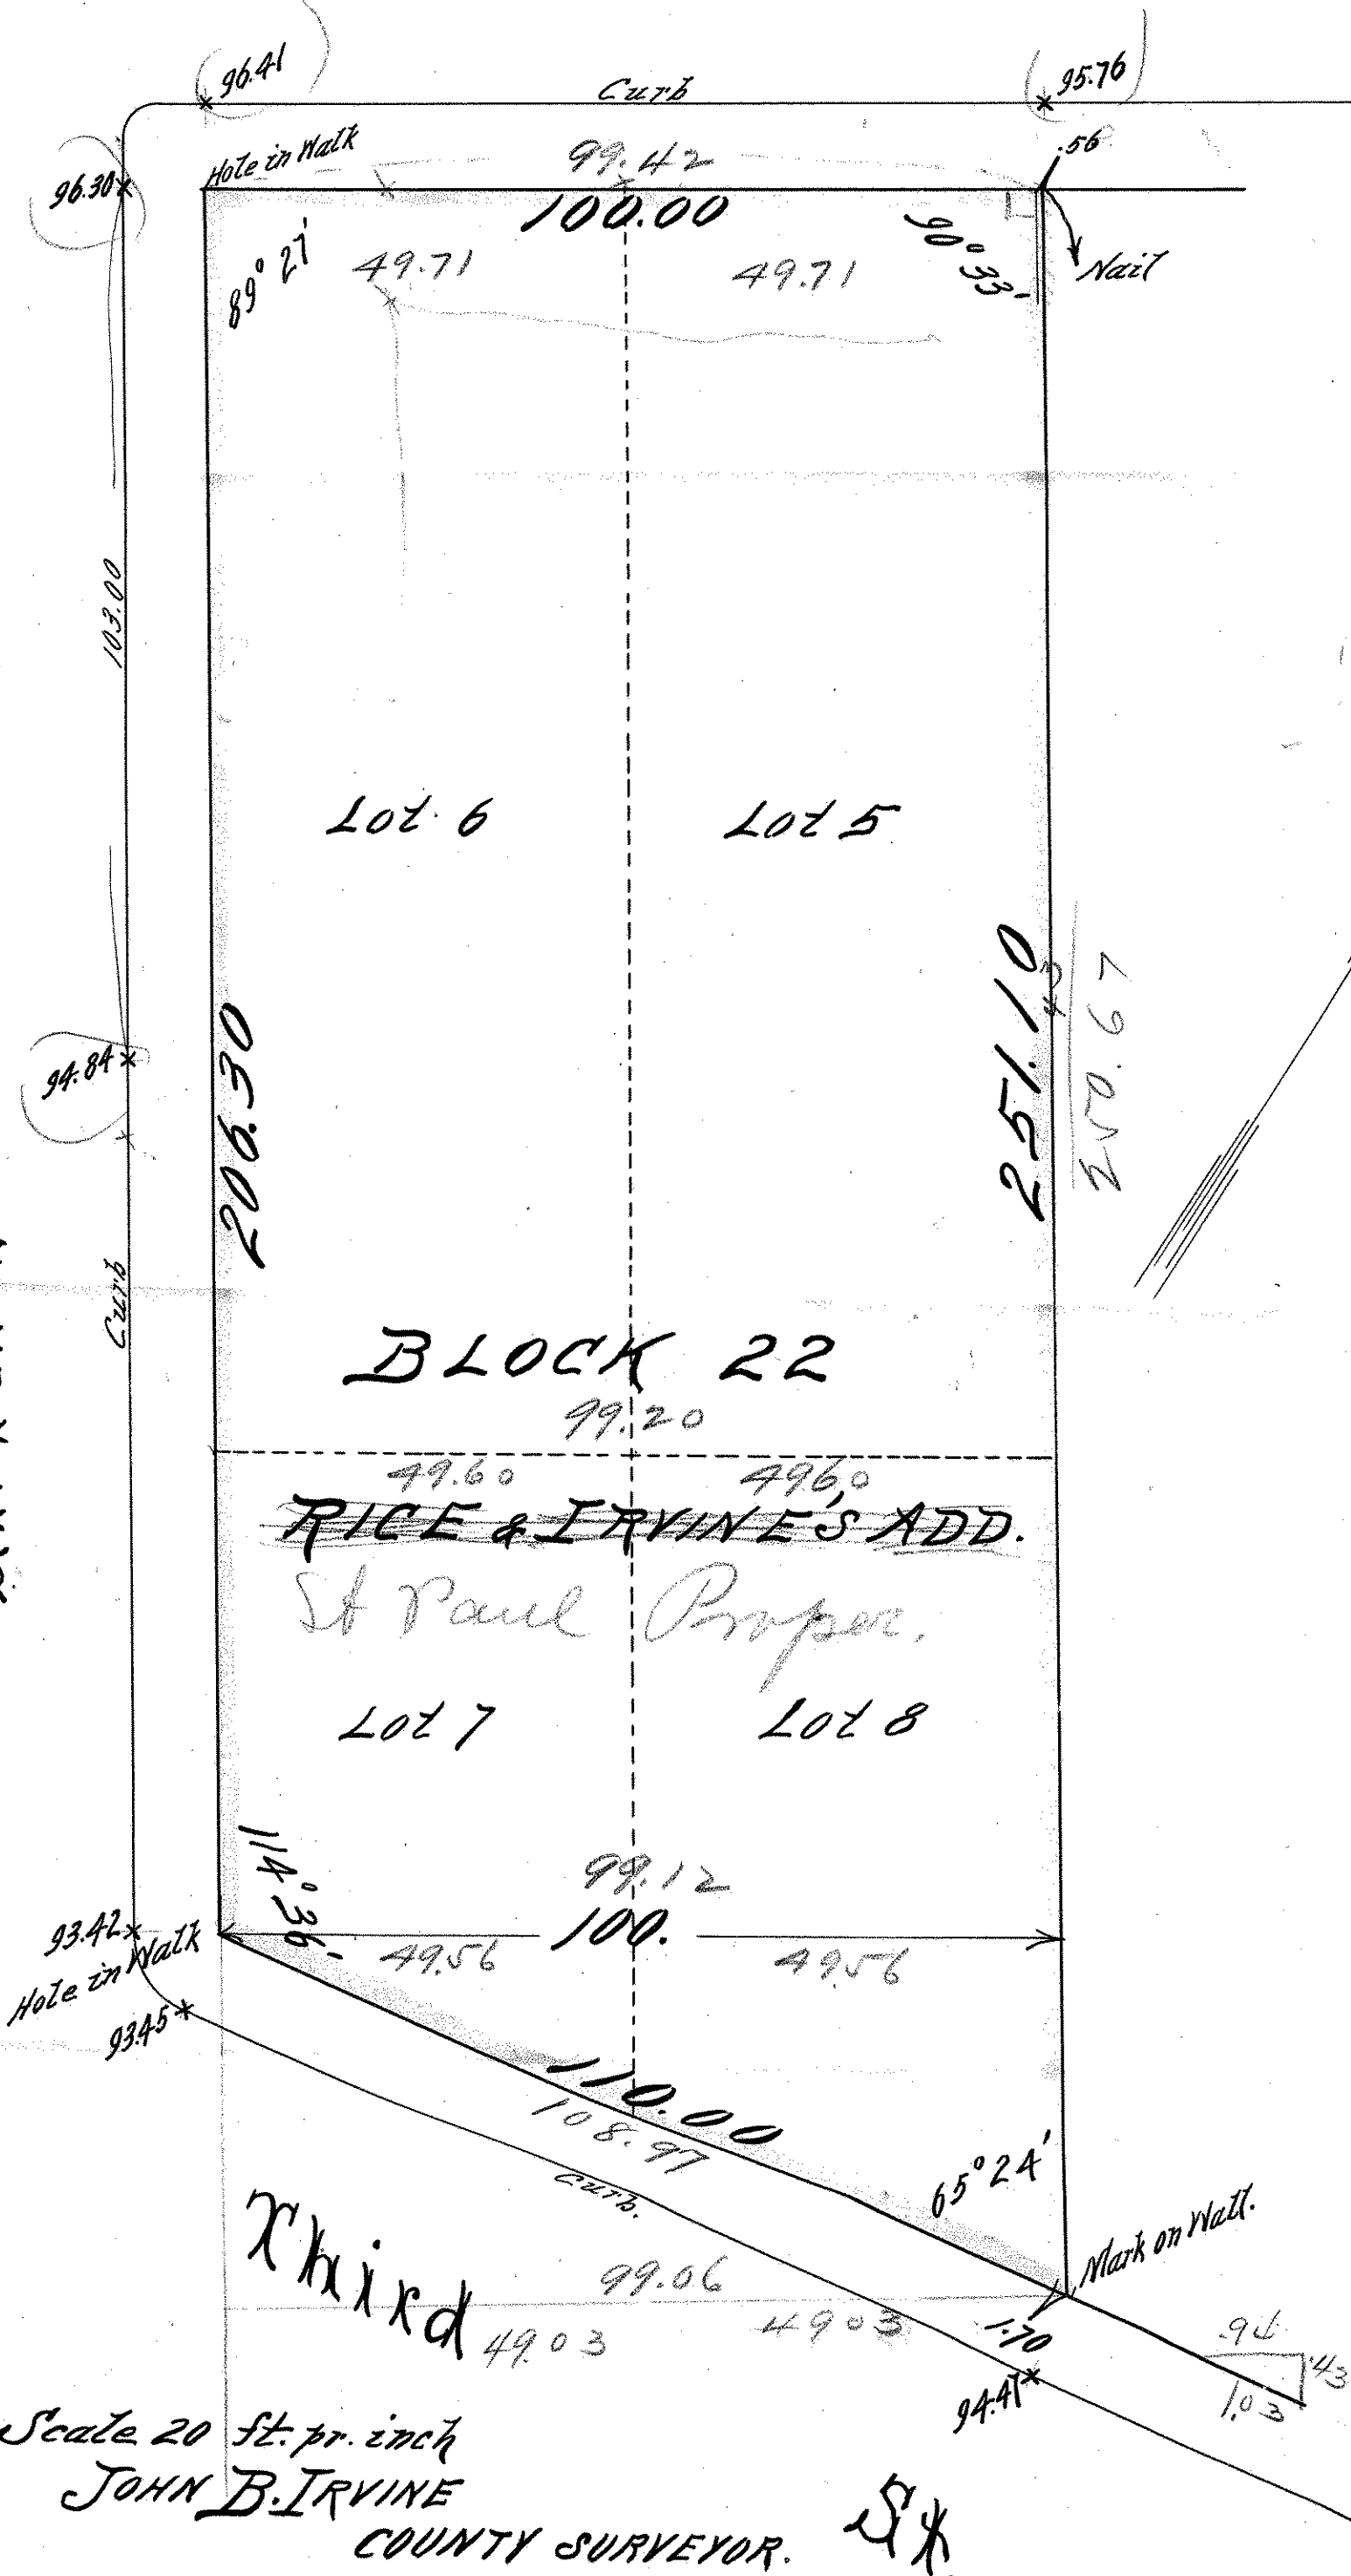

Scale 20 ft. pr. inch

JOHN B. IRVINE
COUNTY SURVEYOR.

St.

May 16th 1901