


LOT 4 AND WESTERLY PART OF LOT 9
BLOCK 22 ST. PAUL PROPER.

JOHN B. IRVINE
County Surveyor

Scale 20 Feet pr. inch.
Dec. 3rd 1904

FOURTH ST.

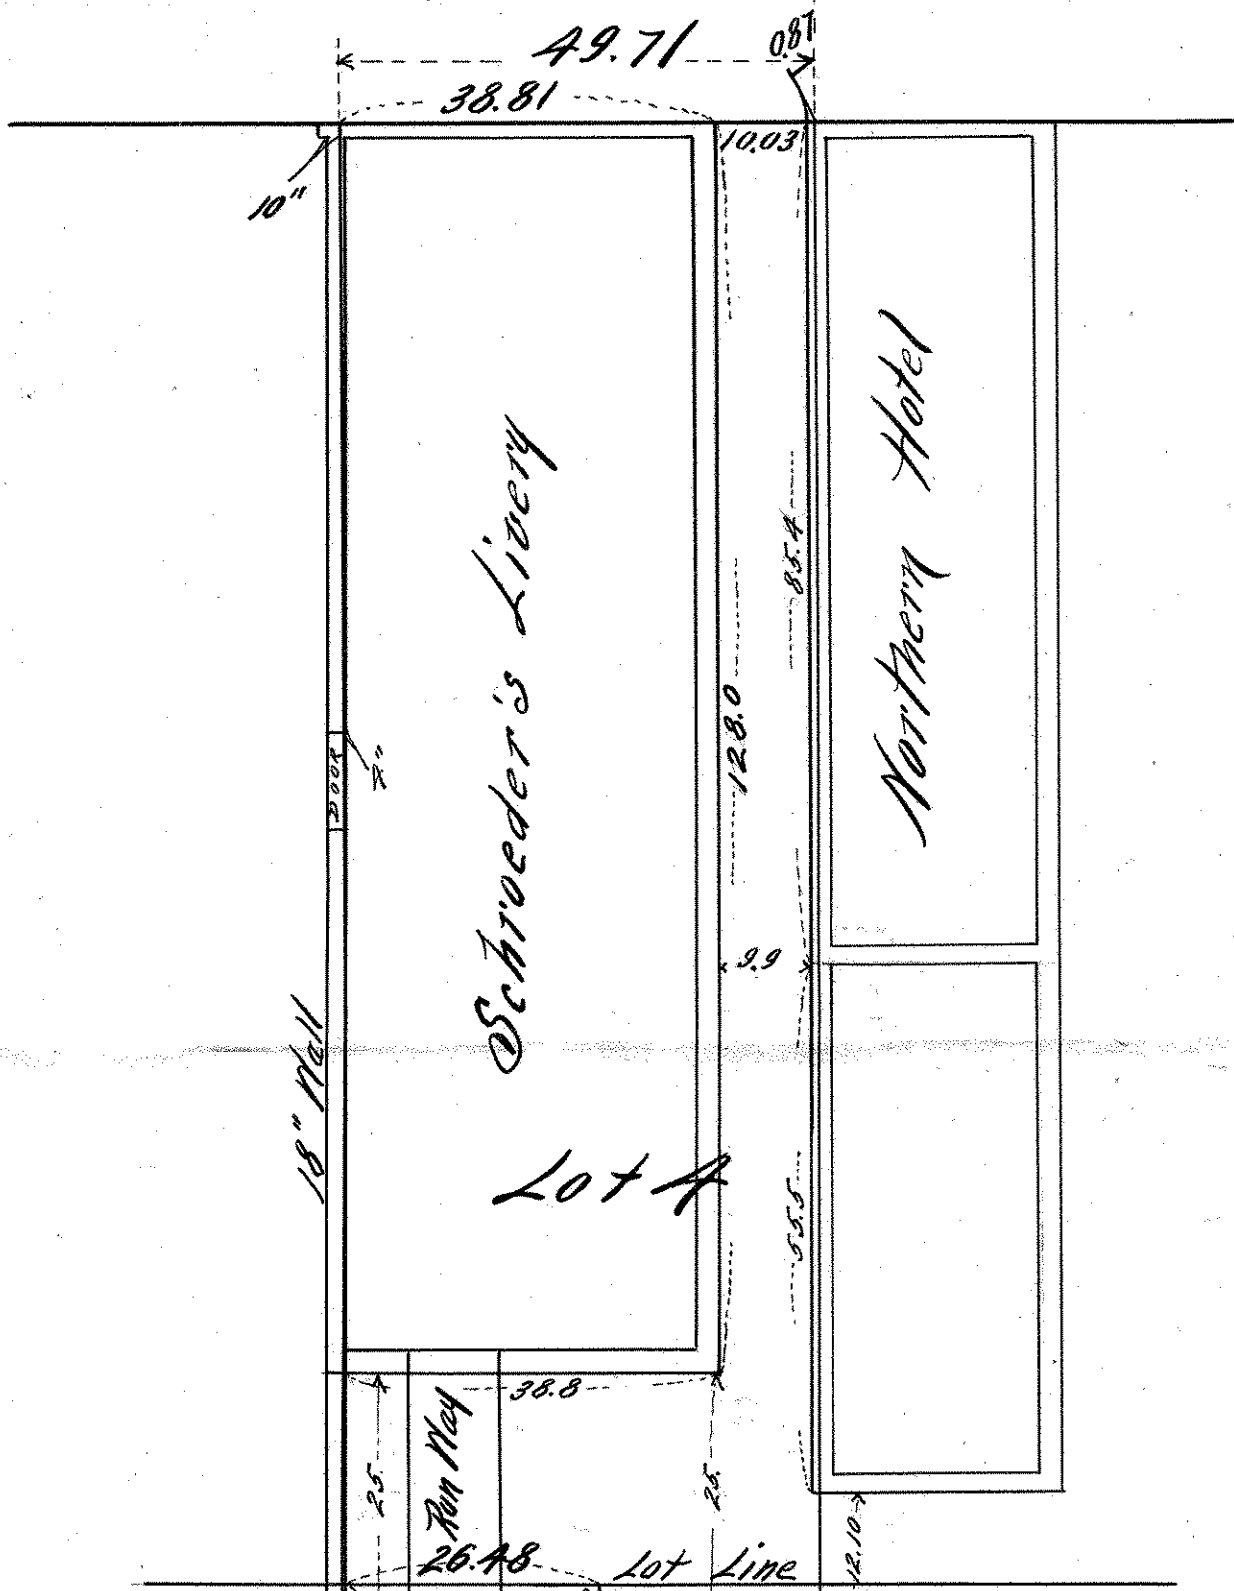

THIRD

ST.