

*SURVEY SHOWING
LOCATION OF WALLS
BETWEEN LOTS 4-5 & 8-9 BLK. 22.
ST PAUL PROPER.*

JUNE 8-1901.

*JOHN B. IRVINE.
COUNTY SURVEYOR.*

ST.

SCALE 20' per. inch

FOURTH


ST.

WABASHA

ST.

ST PETER

ST.

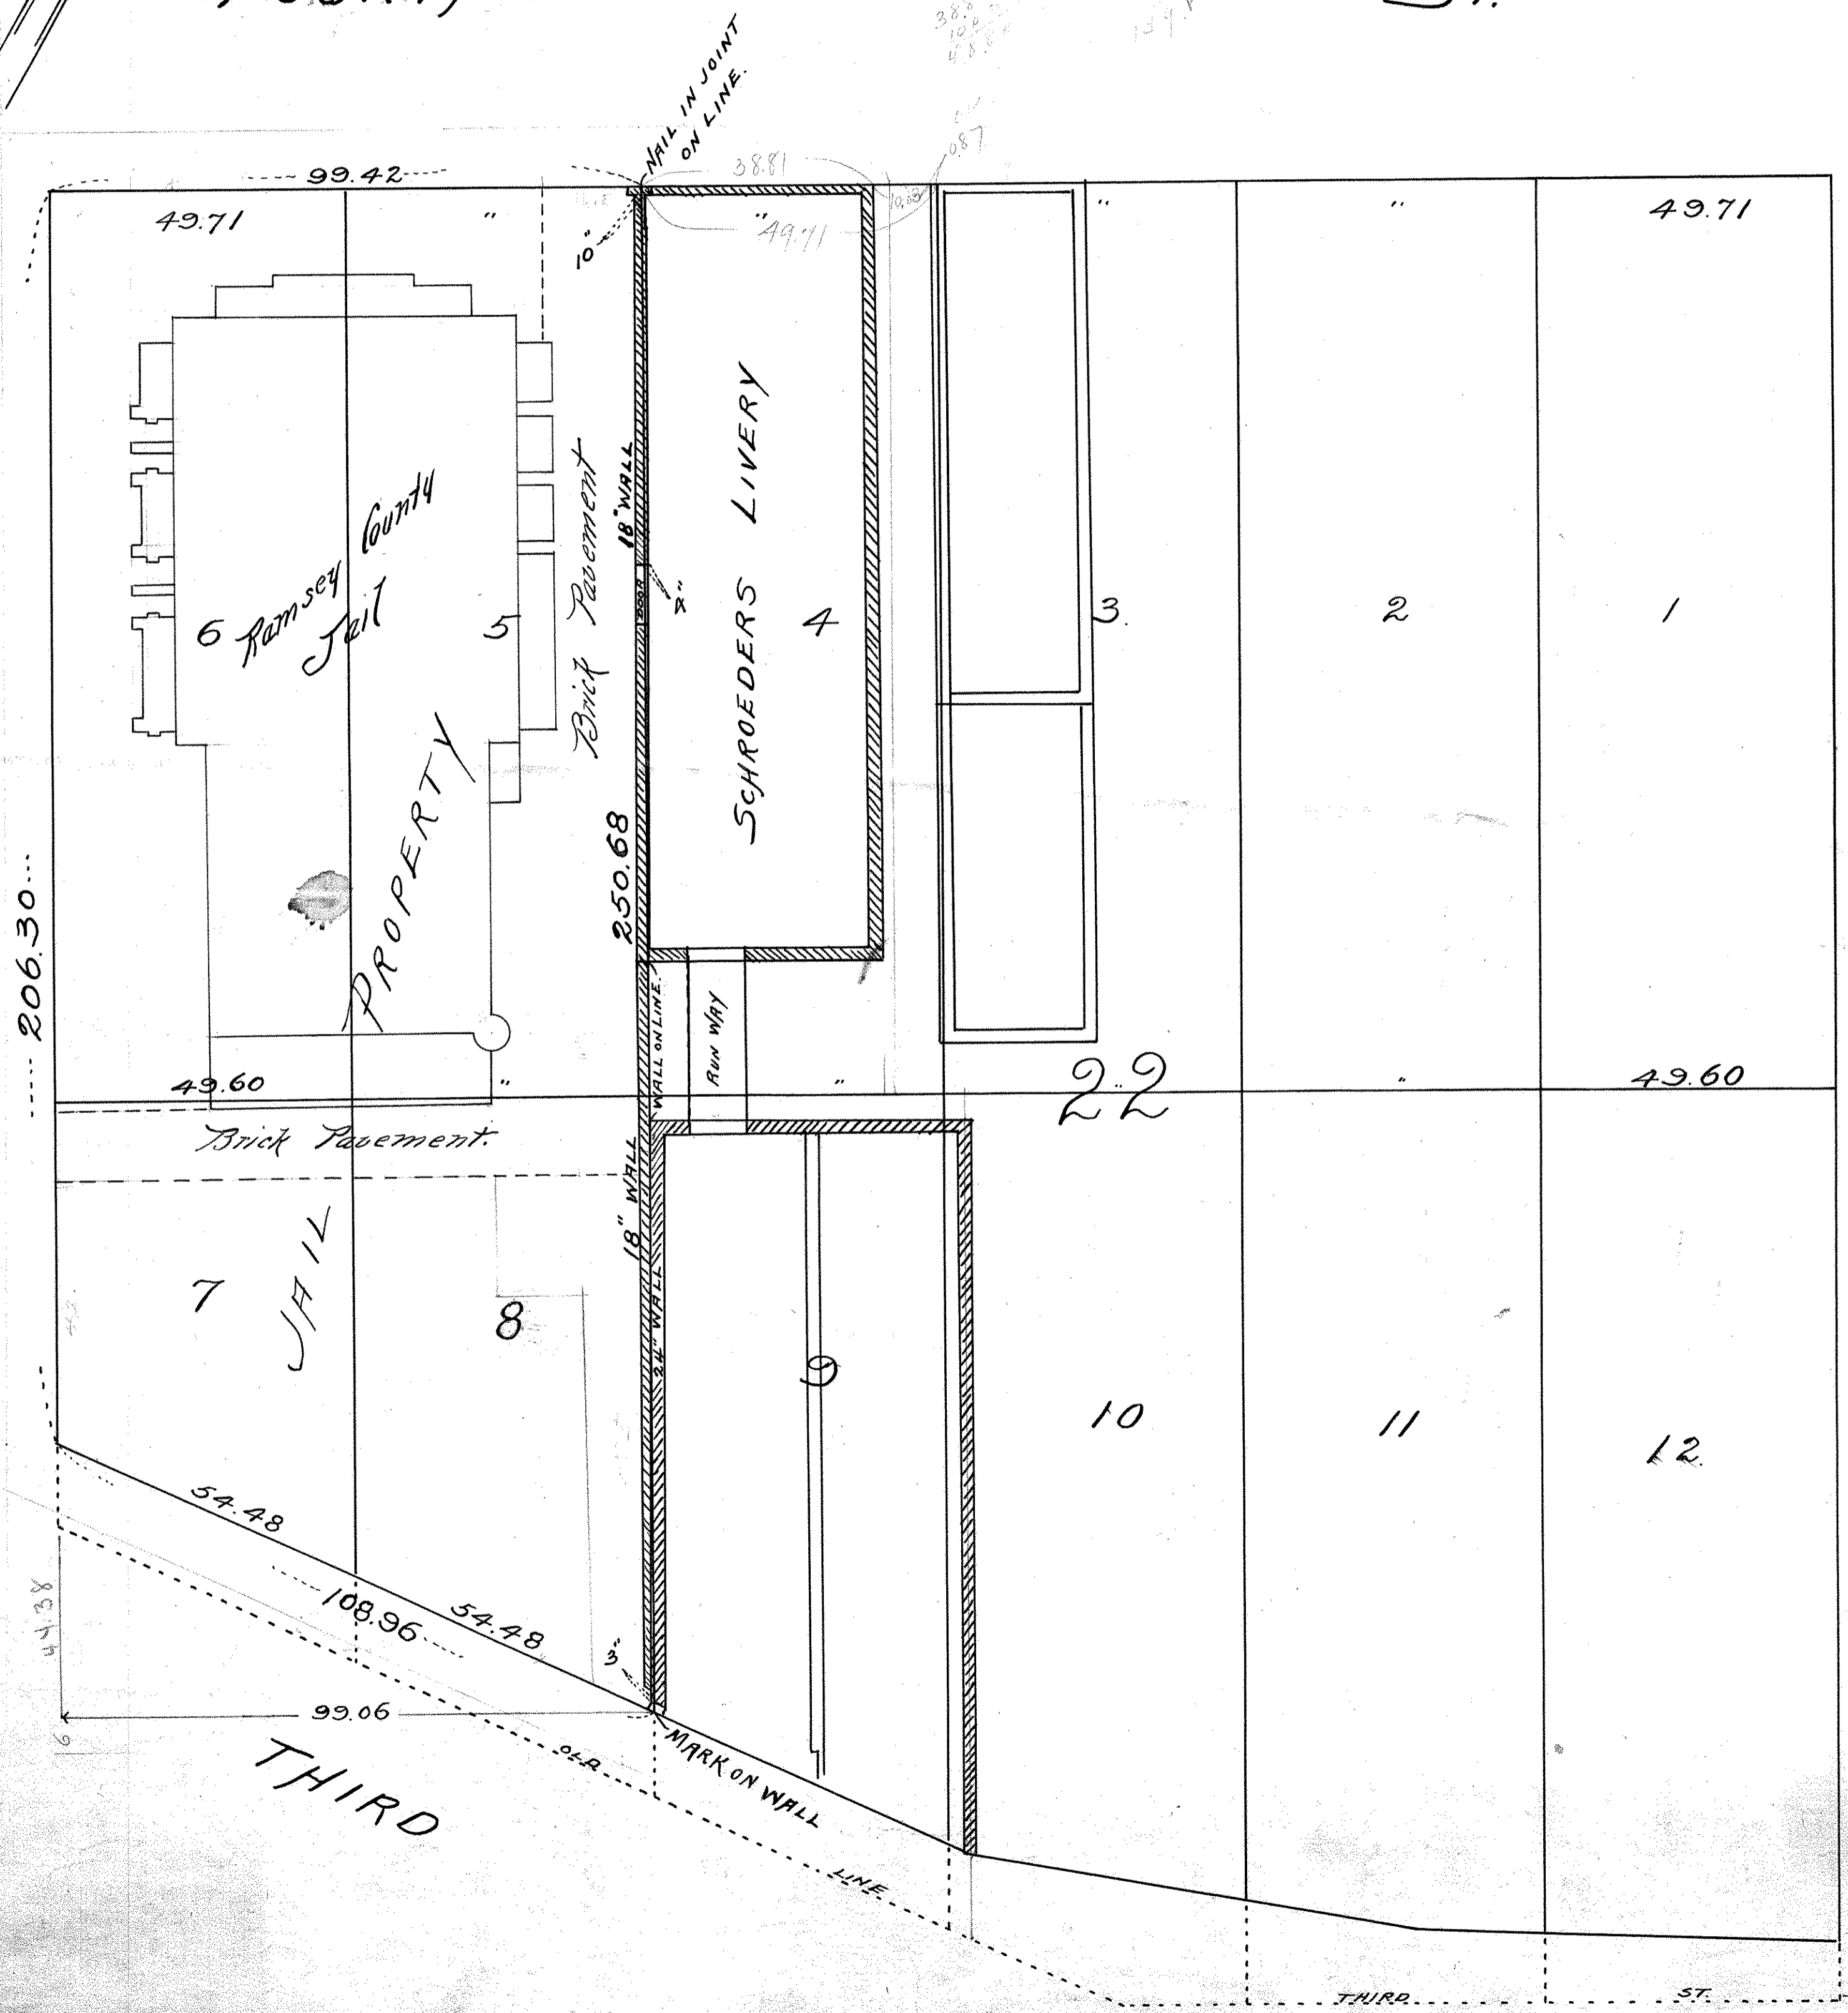

49.71

99.42

NAIL IN JOINT
ON LINE.

3881

49.71

49.71

6 Ramsey County
Jail

Brick Pavement

18" WALL

SCHROEDERS LIVERY

4

3

2

1

250.68

Run way

22

49.60

49.60

Brick Pavement

7

JAIL

8

9

10

11

12

54.48

108.96

54.48

99.06

MARK ON WALL

THIRD

THIRD

ST.