
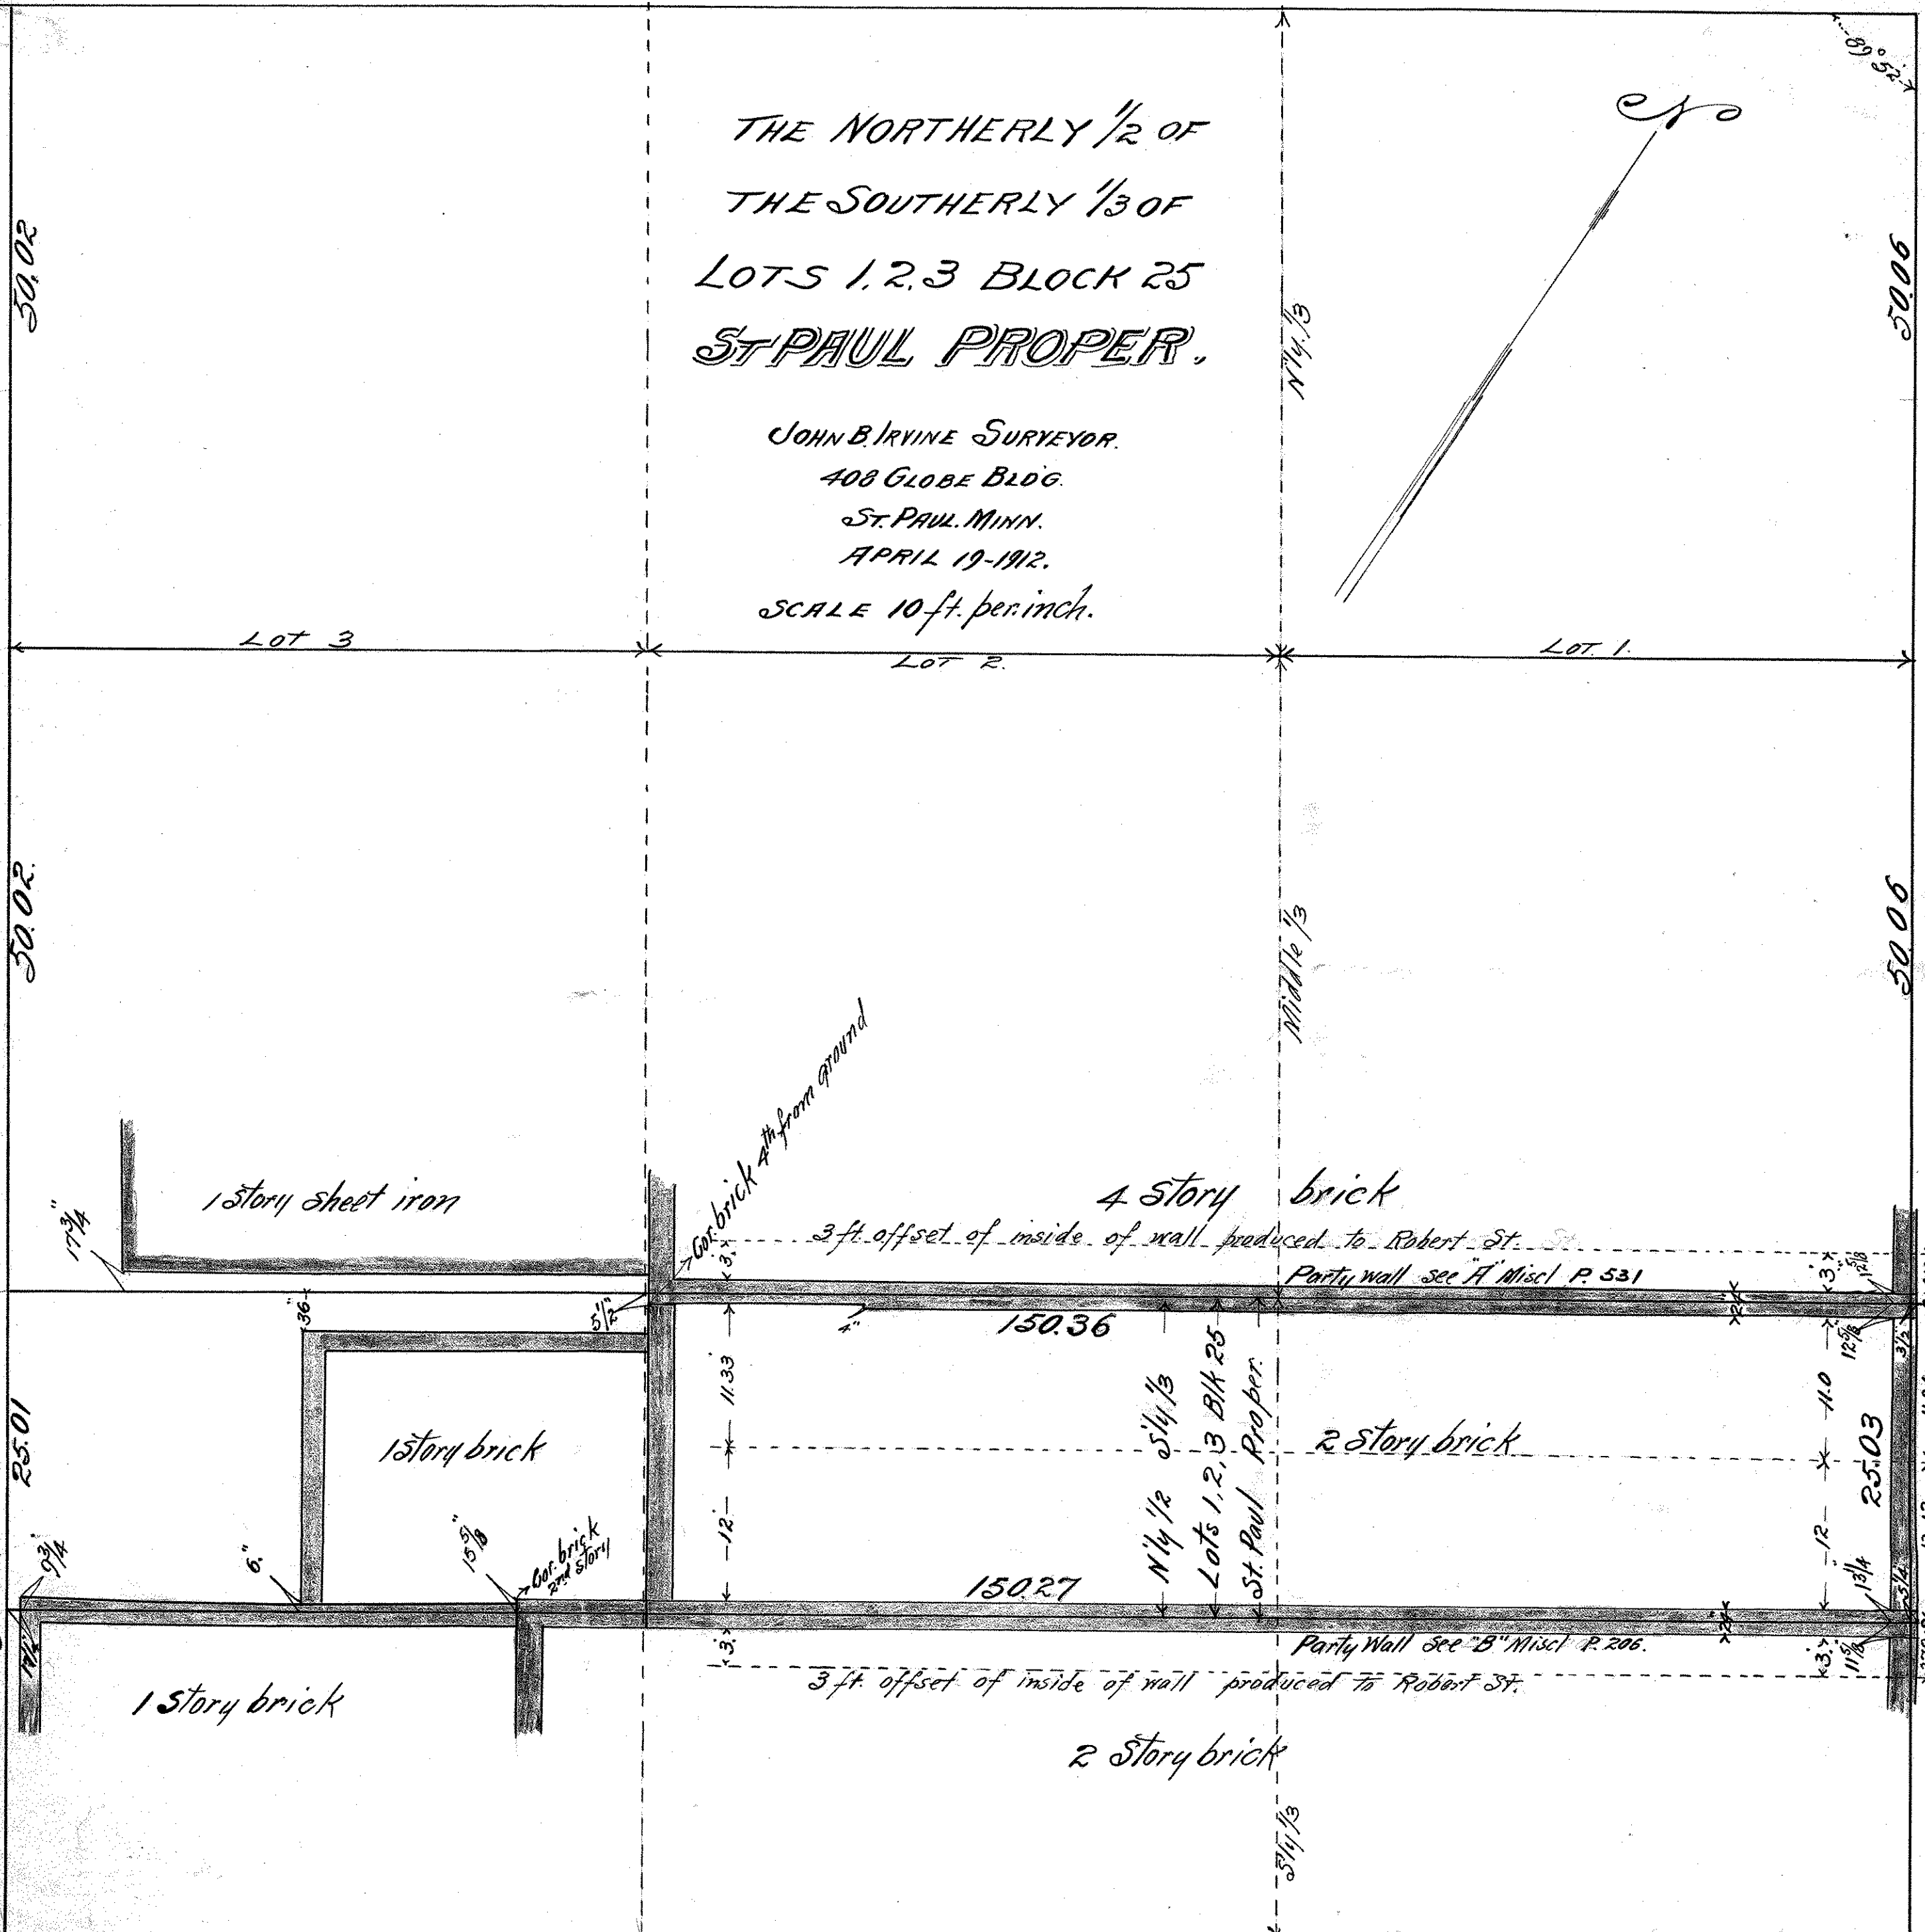


E. FOURTH ST.

THE NORTHERLY 1/2 OF
THE SOUTHERLY 1/3 OF
LOTS 1, 2, 3 BLOCK 25
ST PAUL PROPER.

JOHN B. IRVINE SURVEYOR.
408 GLOBE BLDG.
ST. PAUL, MINN.
APRIL 19-1912.
SCALE 10 ft. per inch.

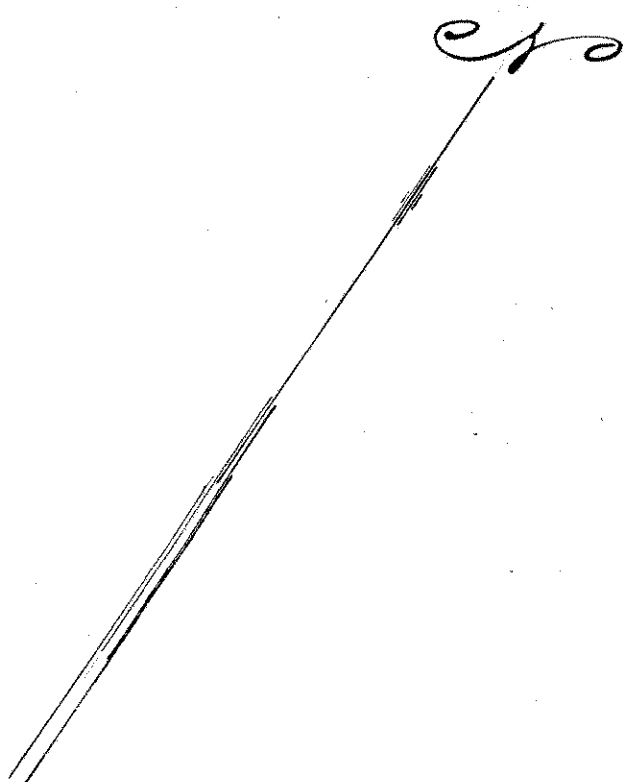

50.02

50.02

25.01

50.02

50.06

50.06

50.02

50.06

ST.

ROBERT

ST.

LOT 3

LOT 2

LOT 1

1 story sheet iron

1 story brick

1 story brick

4 story brick

2 story brick

2 story brick

Cor. brick 4th from ground

Cor. brick 2nd story

3 ft. offset of inside of wall produced to Robert St.
Party wall see "A" Misc. P. 531

3 ft. offset of inside of wall produced to Robert St.
Party wall see "B" Misc. P. 206.

N 1/4 1/2 S 1/4 1/3
Lots 1, 2, 3 Blk 25
St. Paul Proper.

Middle 1/3

S 1/4 1/3

Hole in wall 1 ft. in St.