LOTS 8 & 9 BLOCK 25

ST. PAUL PROPER.
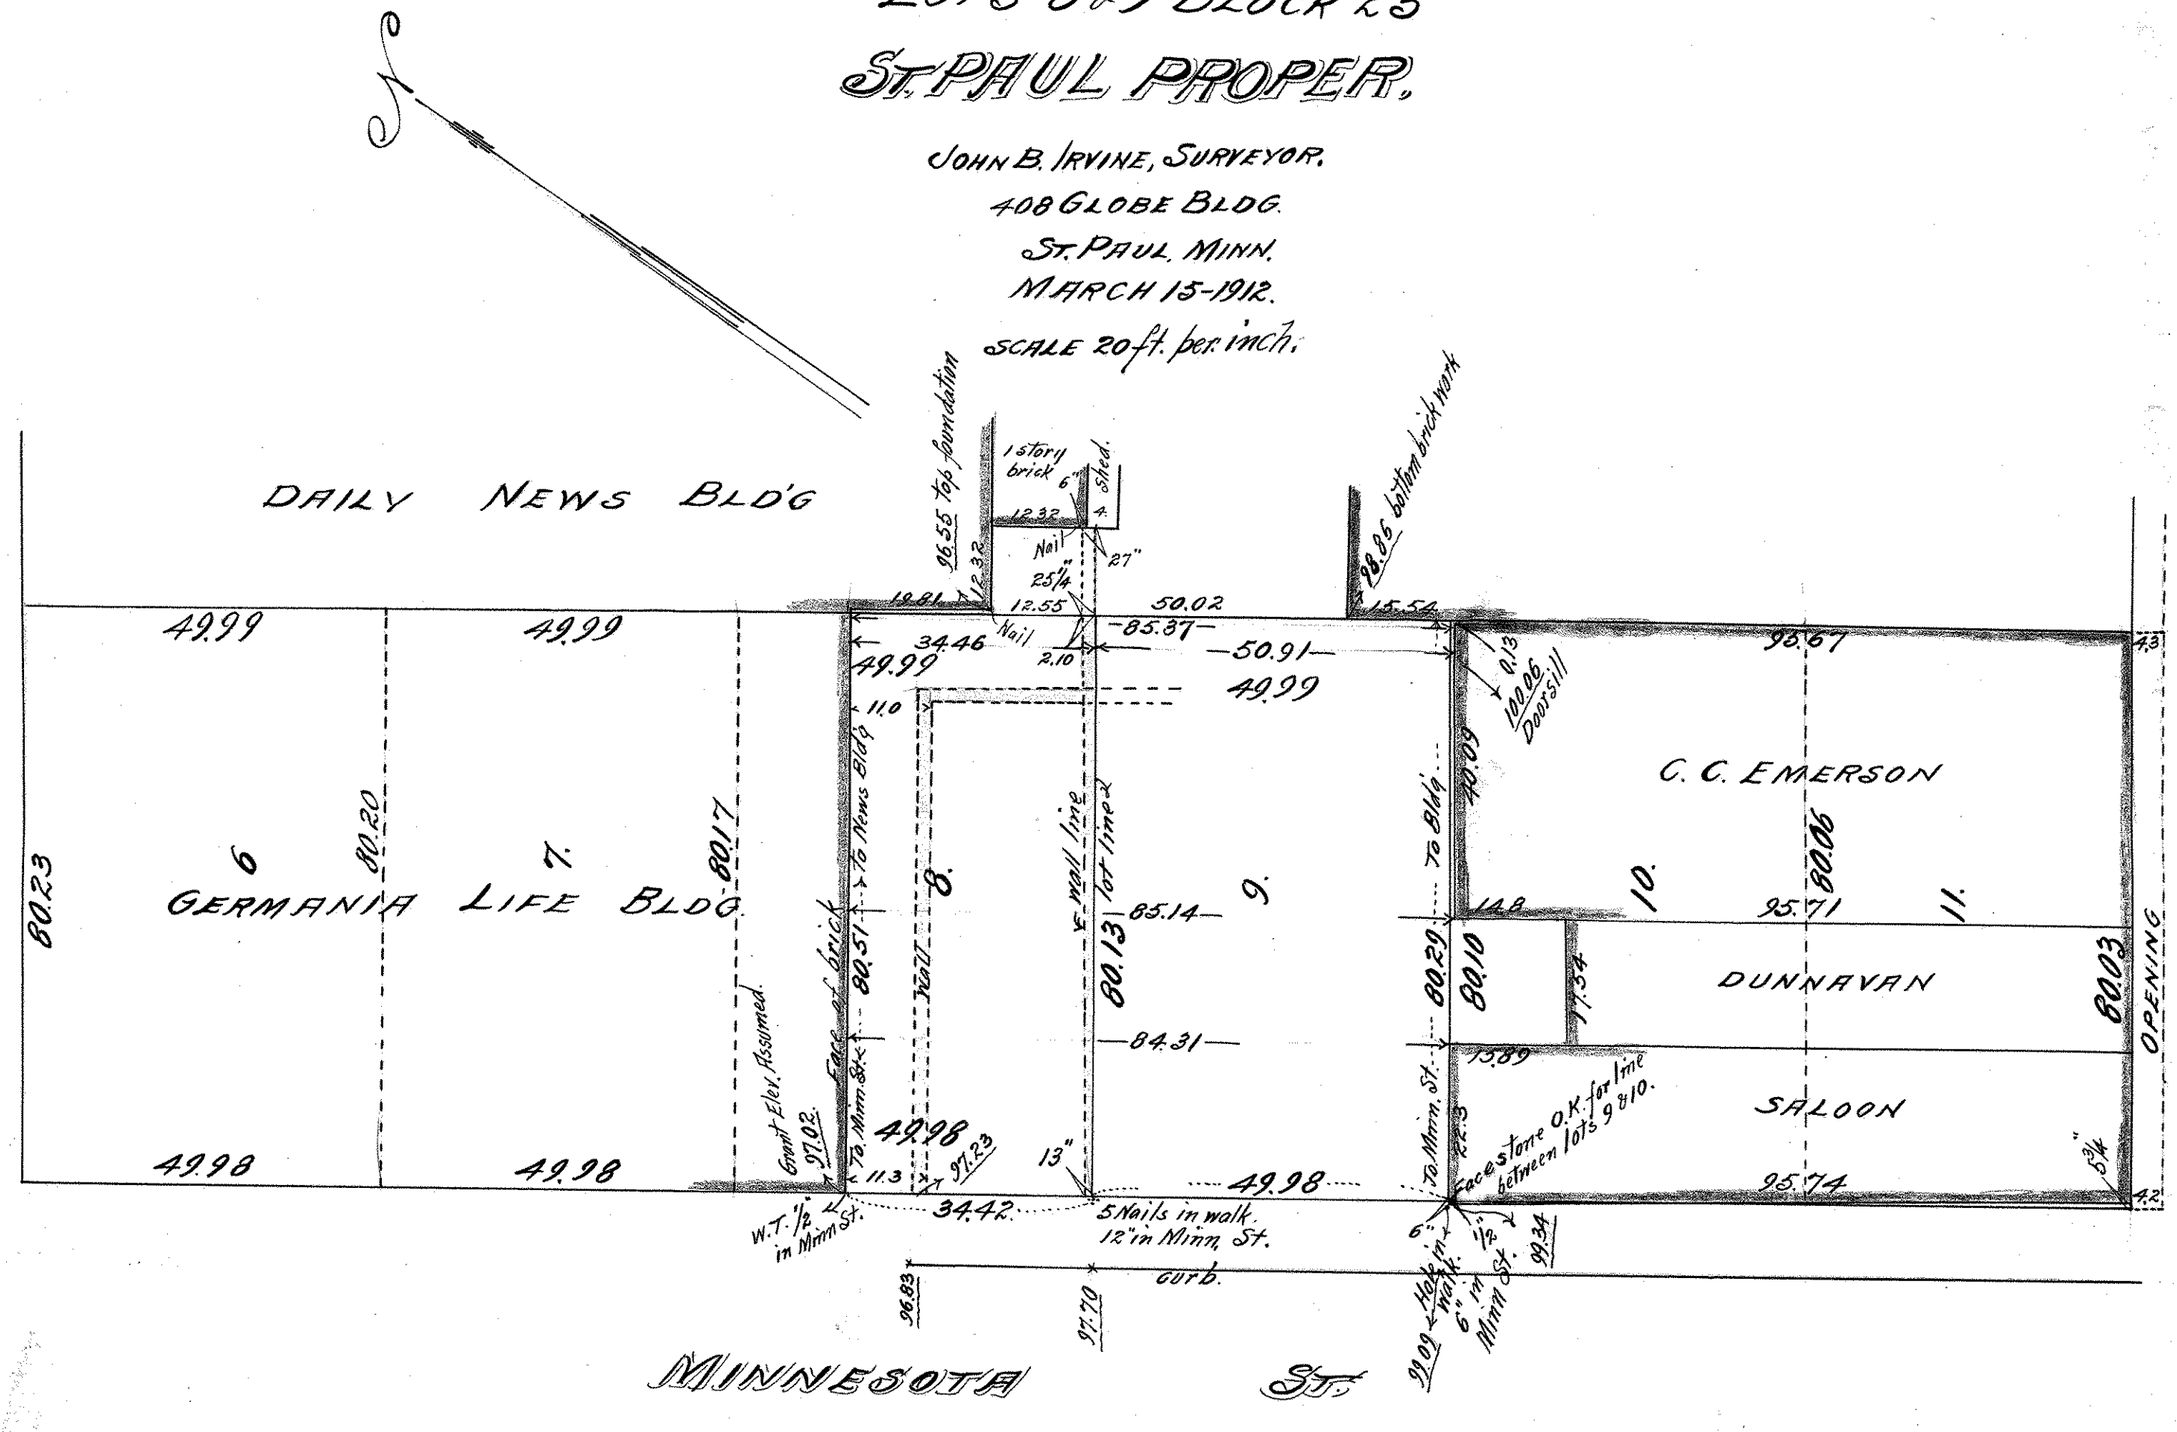
JOHN B. IRVINE, SURVEYOR.
408 GLOBE BLDG.
ST. PAUL, MINN.
MARCH 15-1912.
SCALE 20 ft. per inch.