


FROM THE OFFICE OF

CHARLES O. GEORGI COMPANY

2215 West County Road B

Saint Paul 8, Minnesota

MINNESOTA REGISTERED LAND SURVEYOR

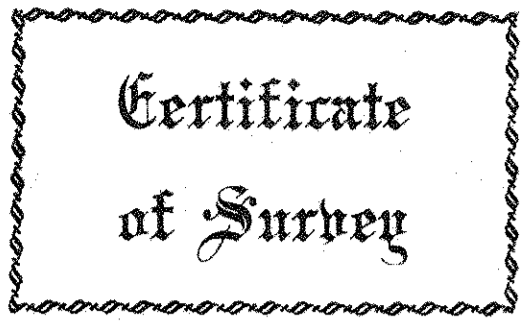

I Hereby Certify that this plat shows a survey made by me of the property described on this plat, and that the corners are correctly placed as shown, and that all locations, encroachments, etc., have been correctly shown. Survey made of block before planned street widening and offset corners were placed. 2/22/66 - noted old street widening and revised description.

Surveyed For *Housing and Redevelopment Authority*

Date *Feb. 1966*

Scale *1" = 50'*

By *Charles O. Georgi*
REGISTERED LAND SURVEYOR

DESCRIPTION:

Lot 1 except the Easterly 33 feet and except the Northerly 4 feet thereof; Lots 2 thru 5 except the Northerly 4 feet thereof; Lot 6 except the Northerly 4 feet and except the Westerly 4 feet thereof; Lots 7 thru 10 except the Westerly 4 feet thereof; Lot 11 except the Westerly 4 feet thereof and except that part taken for Kellogg Blvd. as widened; Lots 12 thru 15 except that part taken for Kellogg Blvd. as widened; and Lot 16 except the Easterly 33 feet thereof and except that part taken for Kellogg Blvd. as widened, all in Block 25, City of St. Paul (St. Paul Proper).
Contains 85,540 sq. ft. more or less.

NOTE:

Agreement to sign plat for recording when completed.

DESCRIPTION: for widening of Minnesota St.

The Westerly 4 feet of Lot 11 except that part taken for widening of Kellogg Blvd., and the Westerly 4 feet of Lots 6, 7, 8, 9 and 10, Block 25, City of St. Paul (St. Paul Proper).
Contains 1181 sq. ft. more or less.

NOTE:

The 4 foot strip along 4th St. and the 13 foot strip along Robert St. are for street widening and same to be dedicated by future plat. (5019 sq. ft. more or less.)

