

PLAN of Wly Wall of Schiffman Bldg. &  
 Ely Walls of Sherman Hotel.  
 LOTS 3, 4, 5 & 6 BLOCK 28  
 ST. PAUL, PROPER.


JOHN B. IRVINE, SURVEYOR.  
 408 GLOBE BLDG.  
 ST. PAUL MINN.  
 JUNE 1-1909.

Lot 3

LOT 4

LOT 5

LOT 6

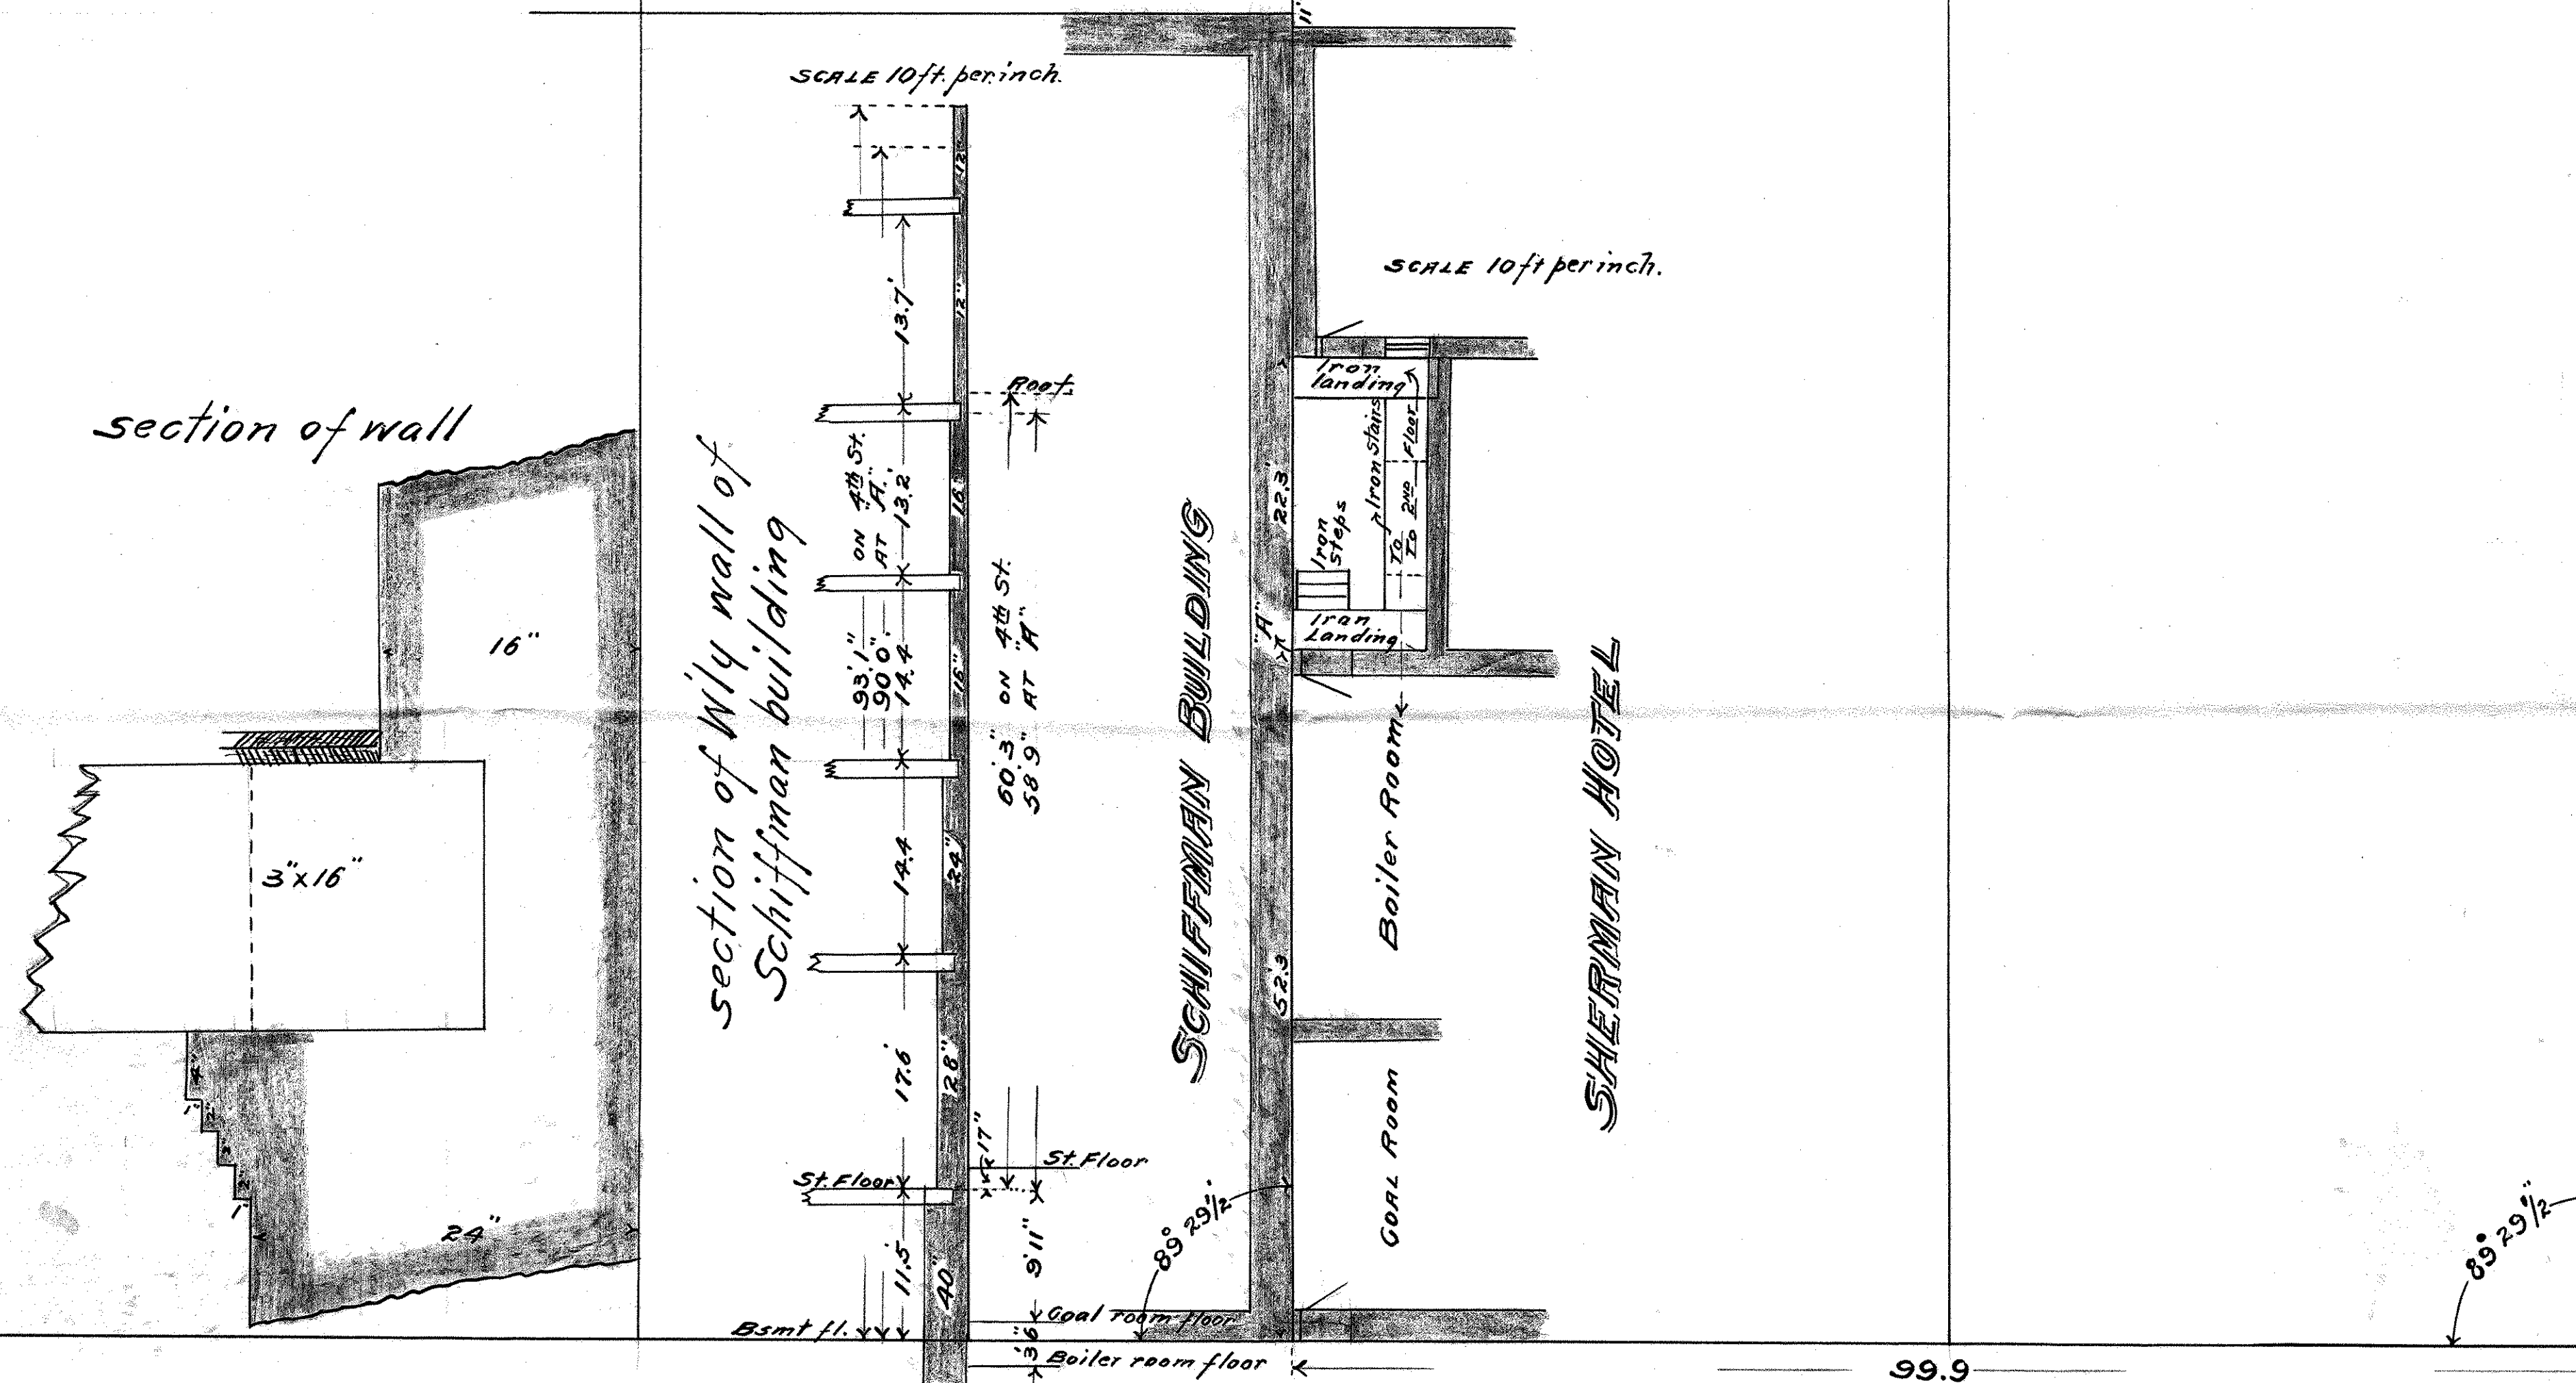

E. FOURTH ST.

SIBLEY ST.