

LOT 7 & NORTH 1/3 LOT 8 BLOCK 28

of ST PAUL, PROPER.


JOHN B. IRVINE, SURVEYOR.

408 GLOBE BLDG.

ST PAUL, MINN.

APRIL 30-1913

scale 10 ft. per. inch.

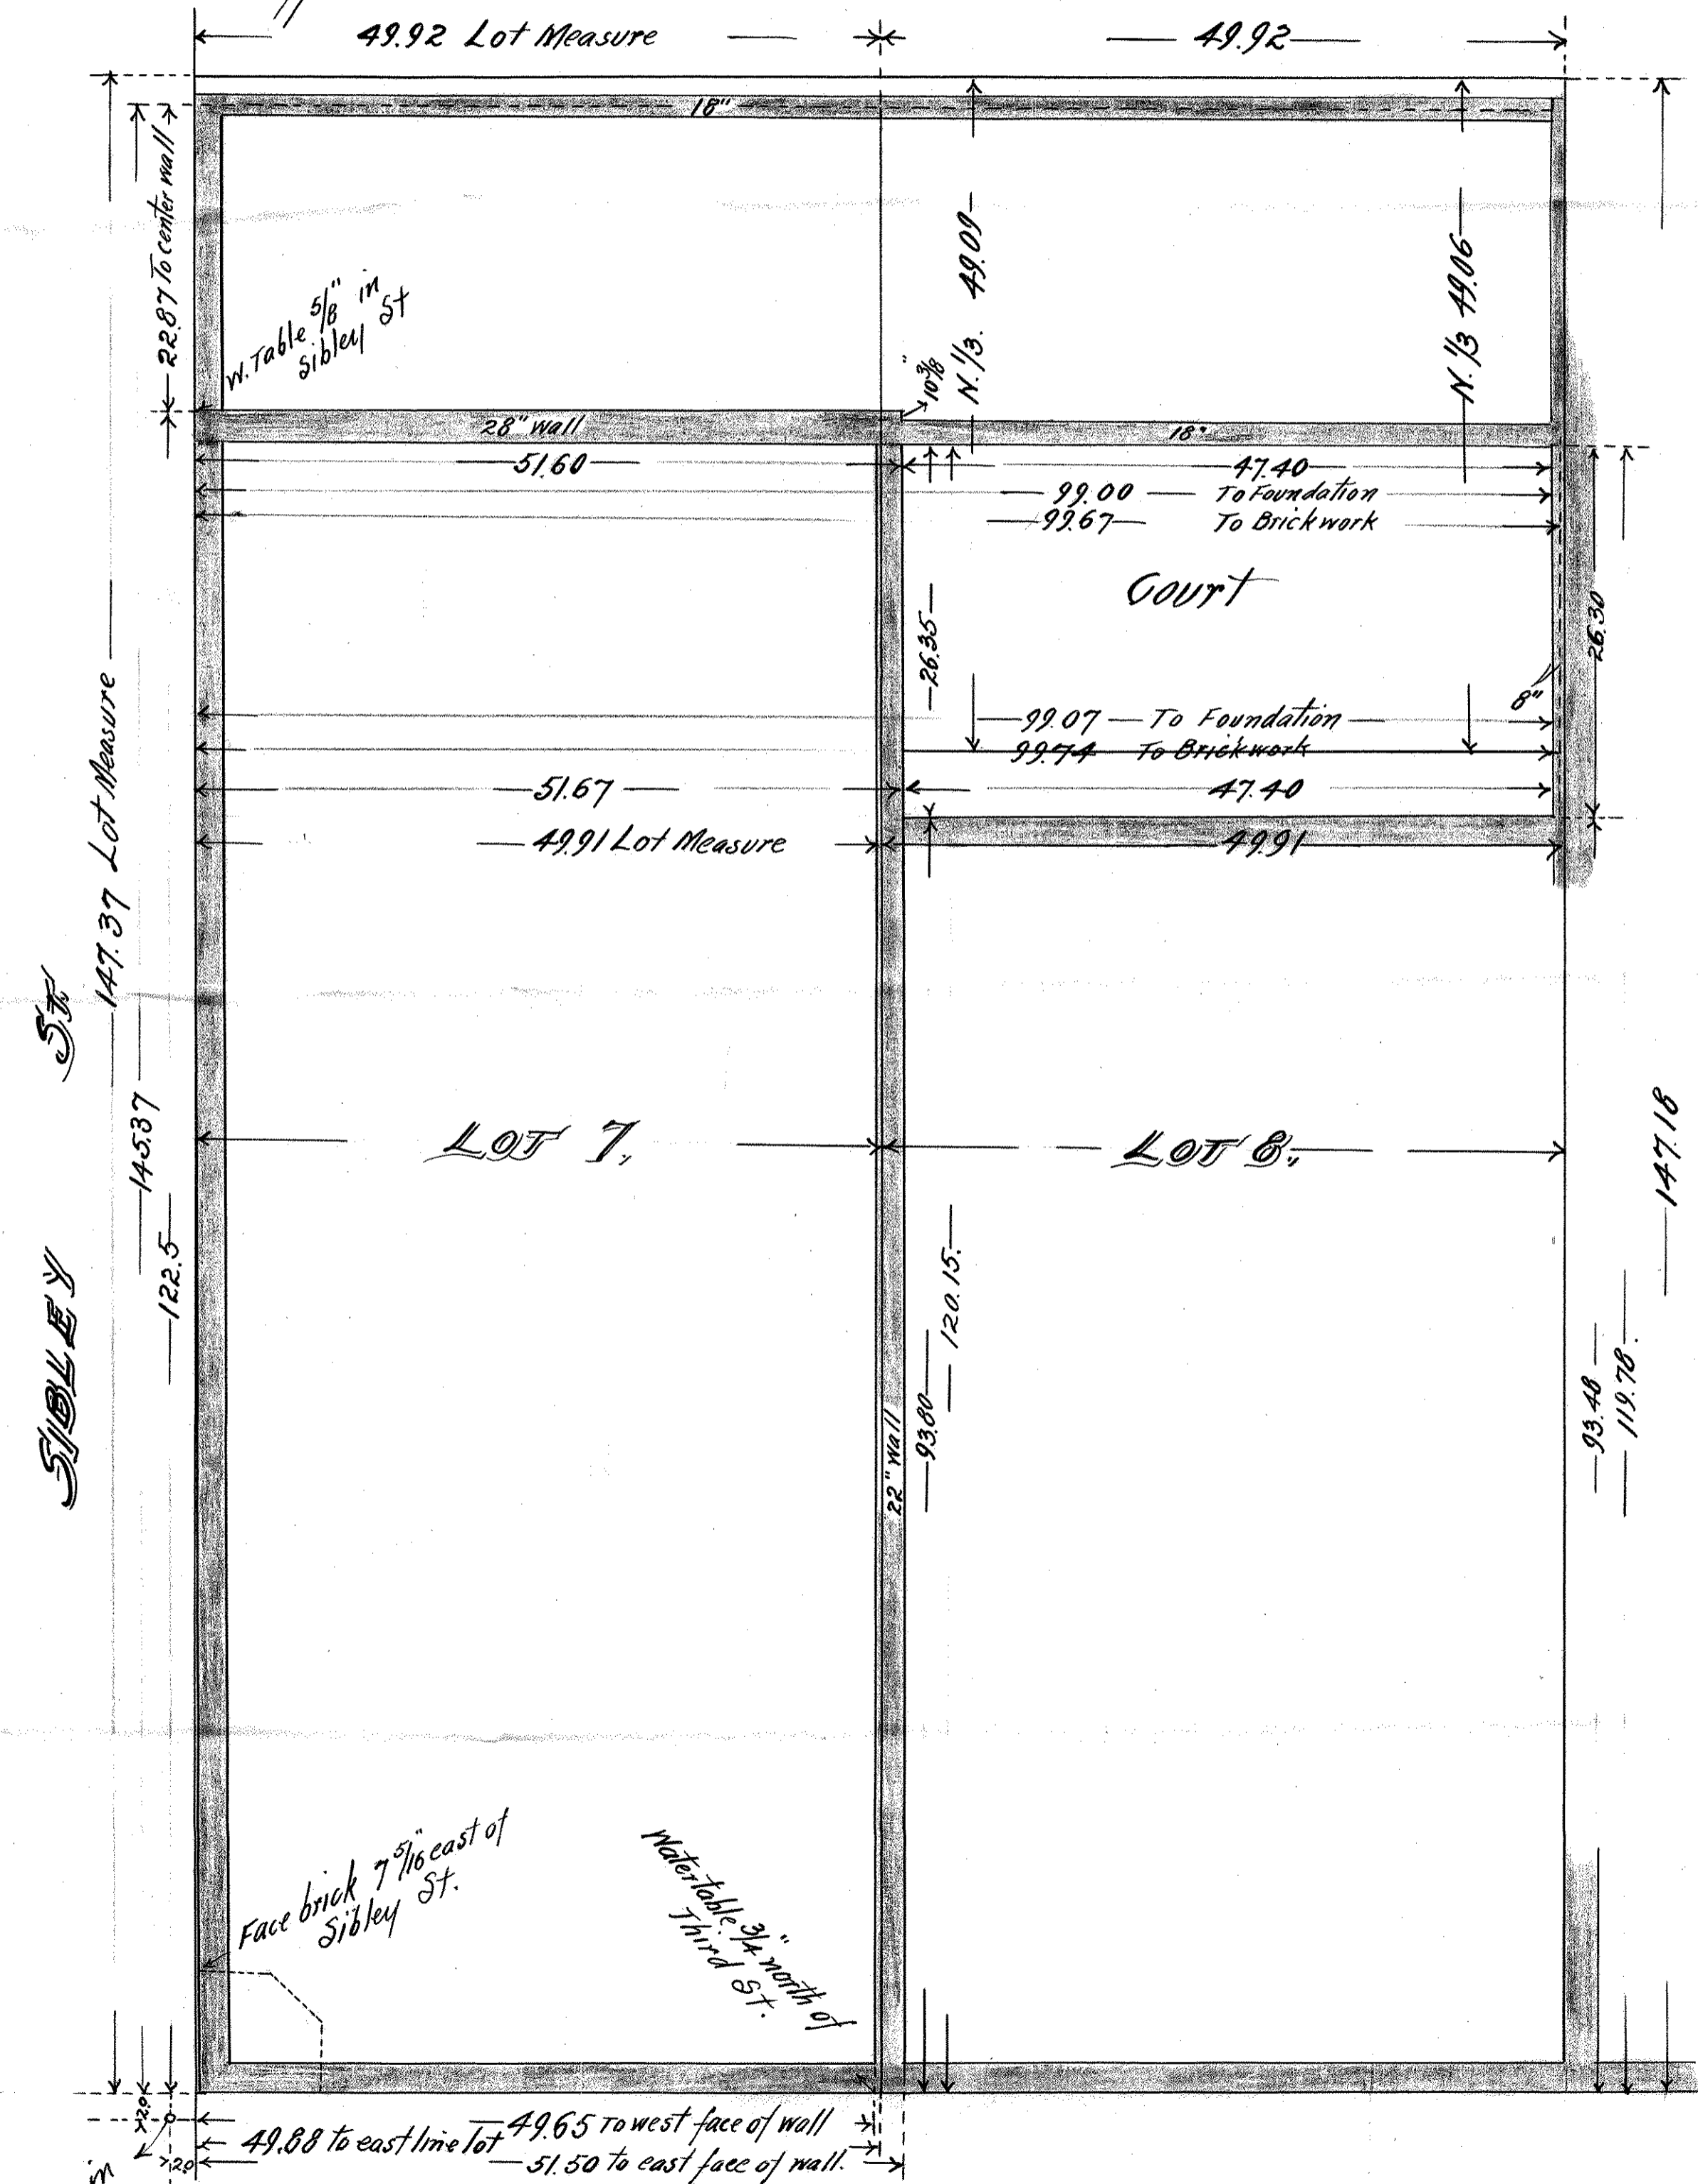

E. THIRD ST.