


THAT PART OF LOT 1 BLOCK 31 ST. PAUL PROPER  
WHICH LIES SOUTH OF THE ALLEY

Scale 20 Feet pr. inch

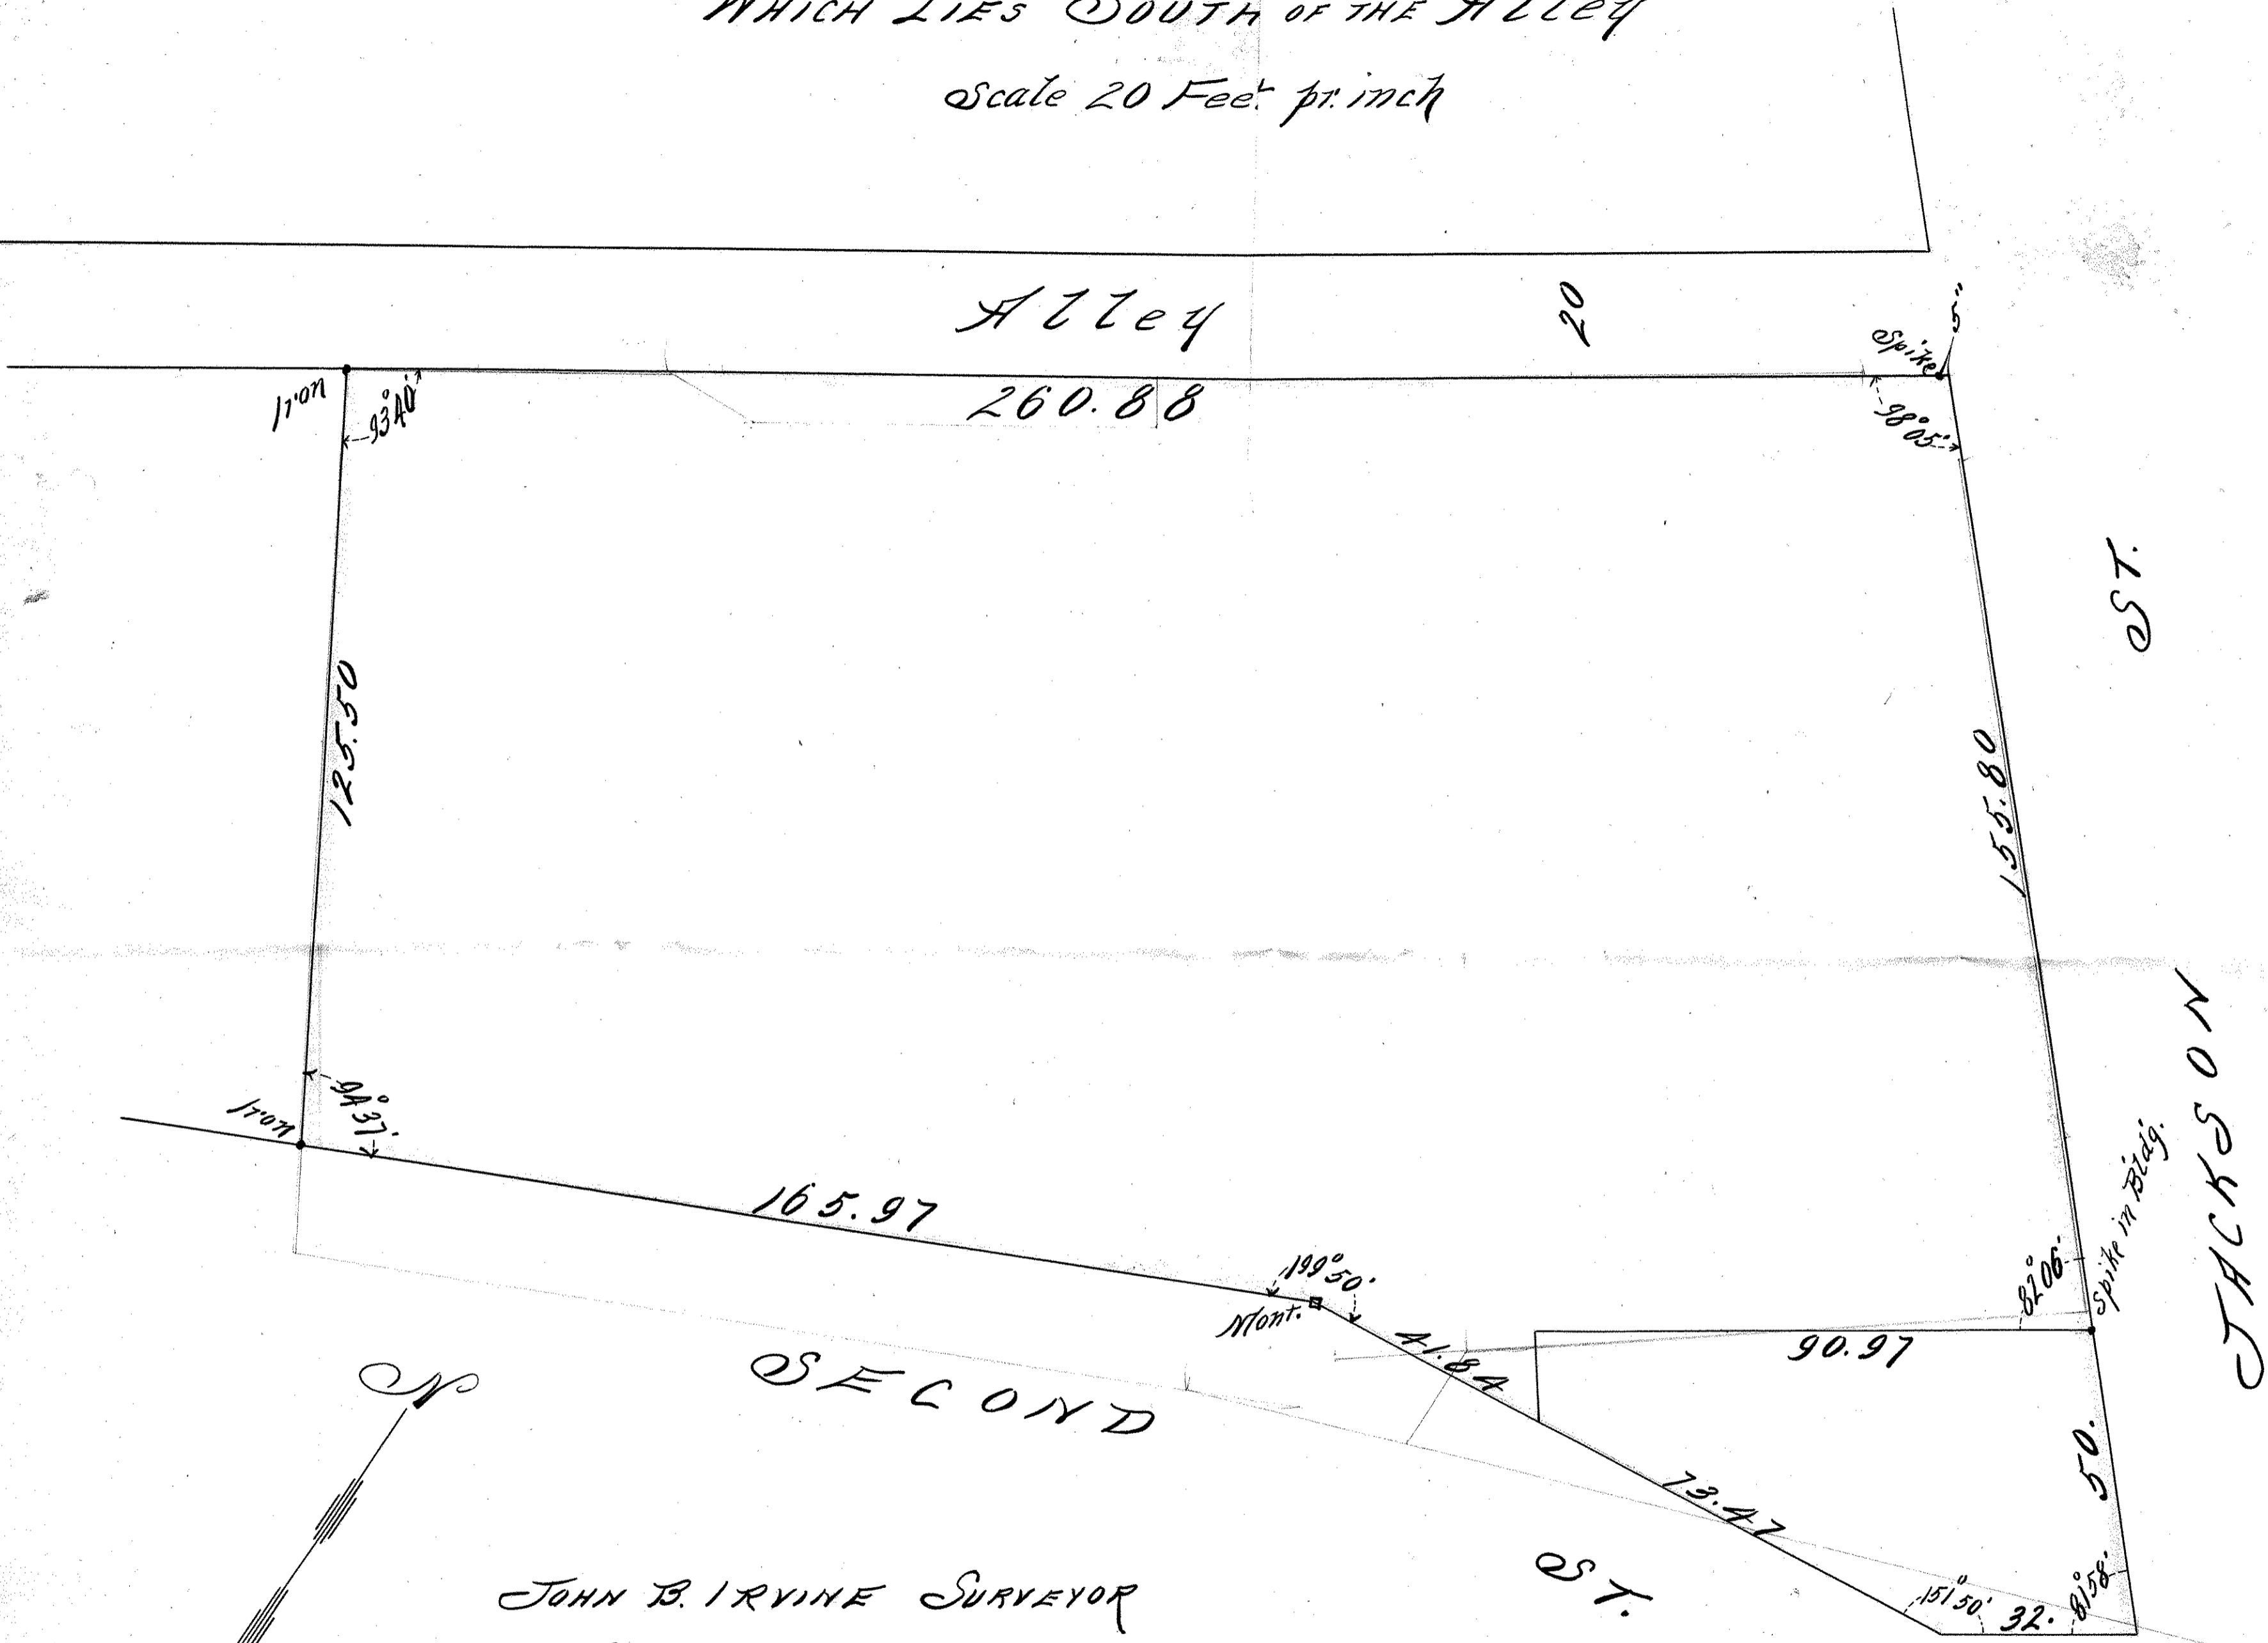

JOHN B. IRVINE SURVEYOR  
Room 16 (out House)