
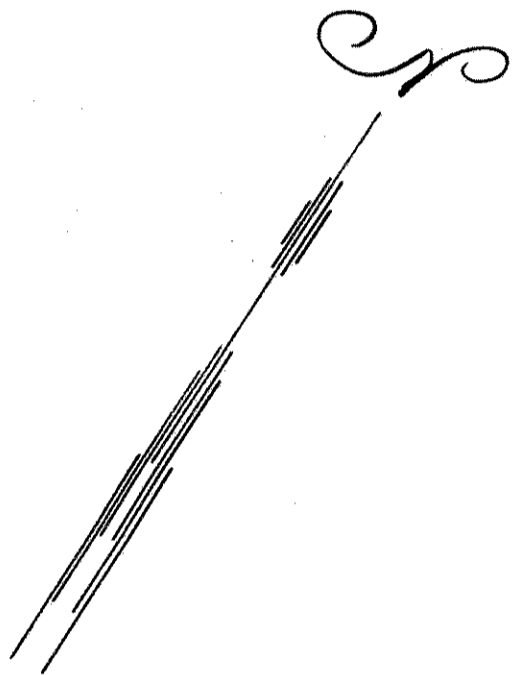


THE WESTERLY 1/2 OF LOT A  
 BLOCK 34 ST. PAUL PROPER  
 Scale 10 Feet pt. inch

THIRD ST.

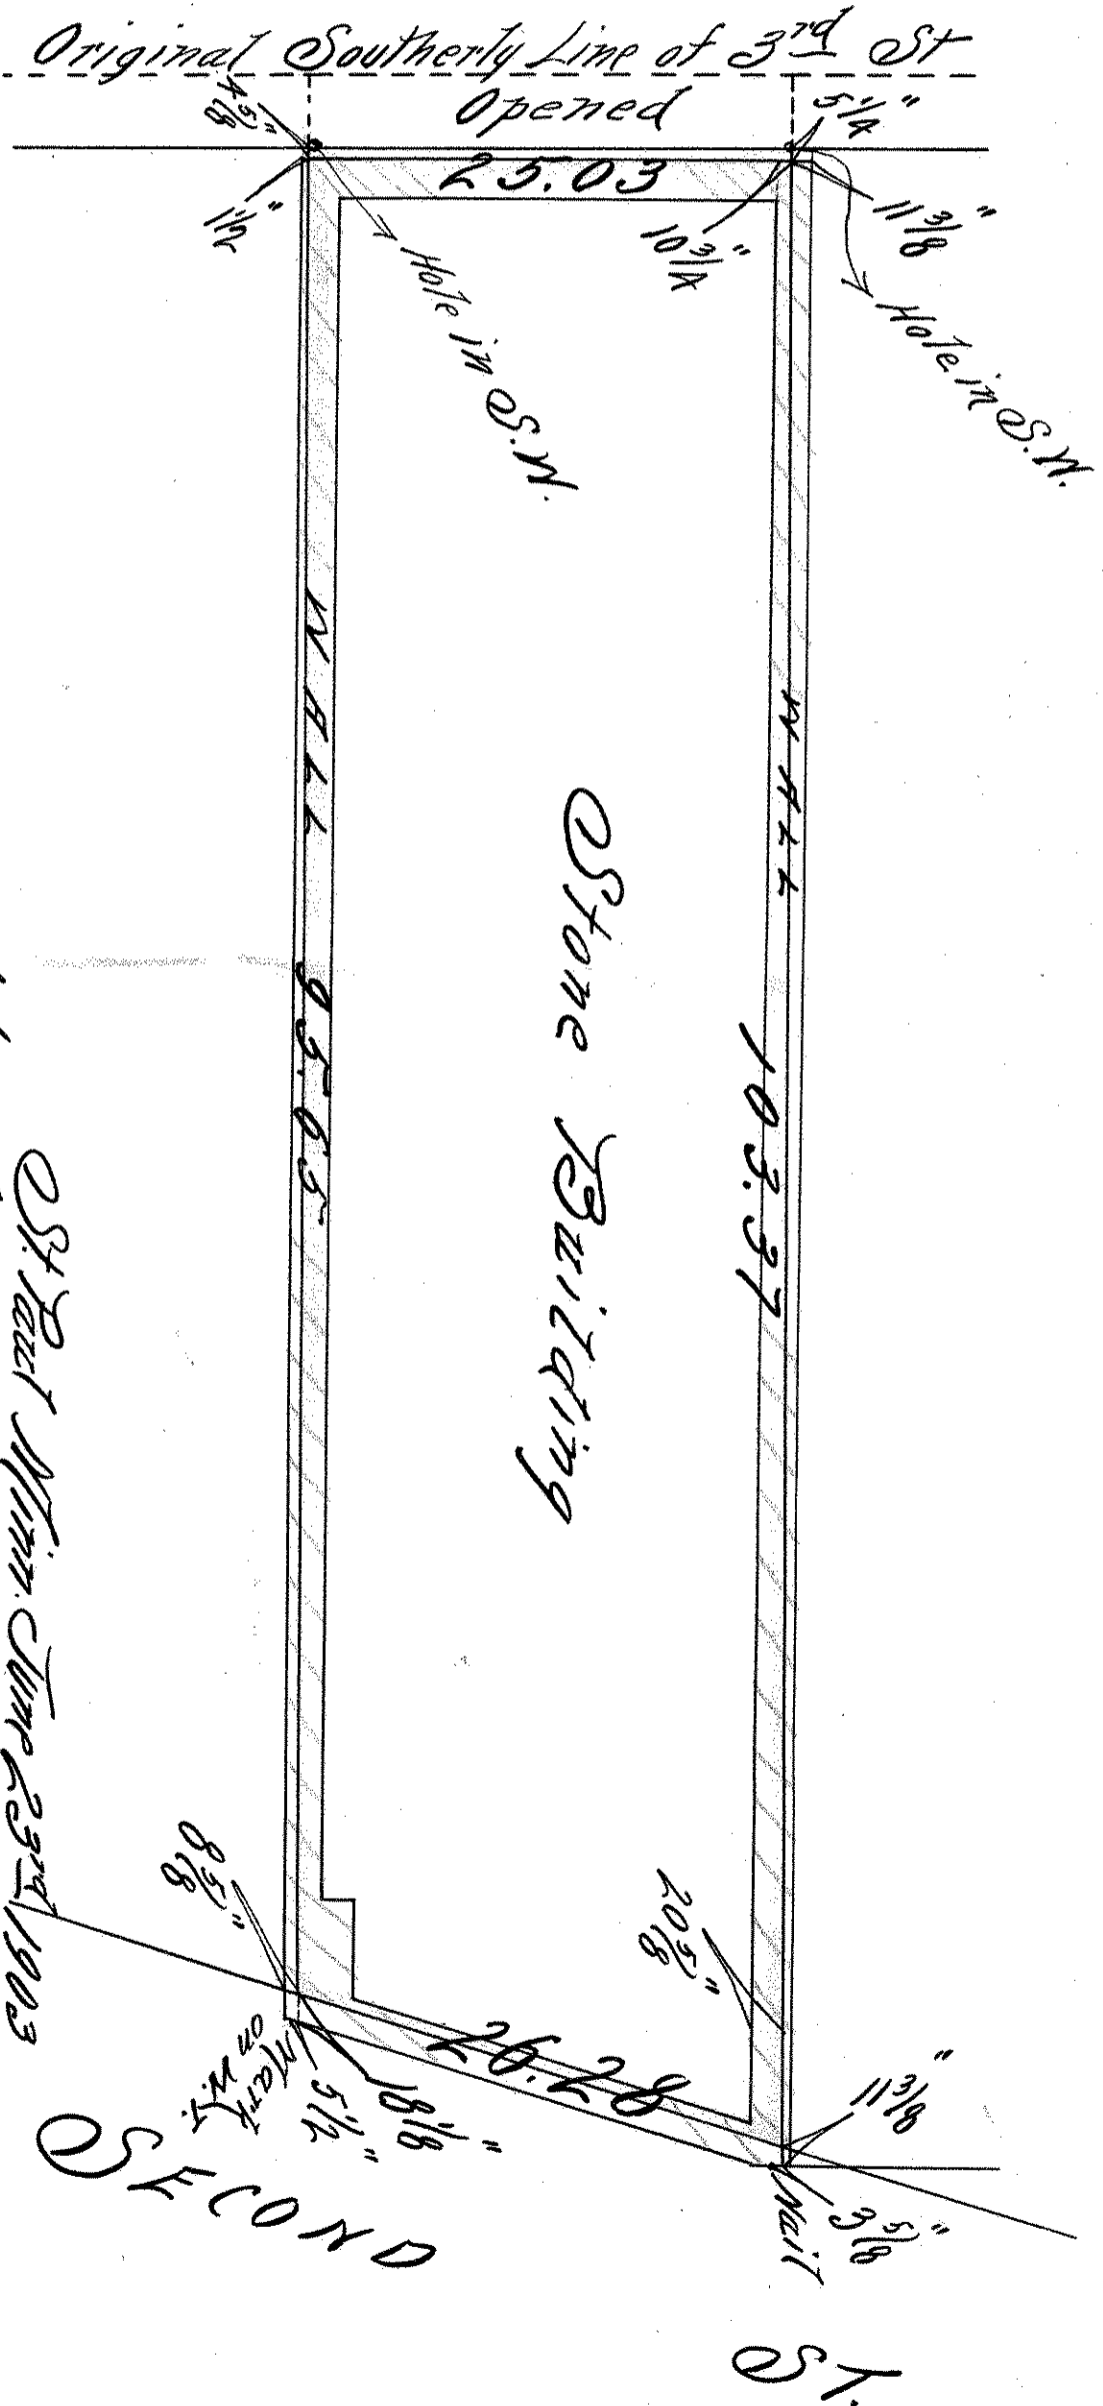

I. hereby certify that this diagram  
 correctly represents "THE WESTERLY  
 1/2 OF LOT A BLOCK 34 ST. PAUL  
 PROPER" as surveyed by me this day.  
 John B. Irvine.  
 County Surveyor  
 Room 16 Court House

St Paul Minn. June 23<sup>rd</sup> 1903  
 Telephone: 334 T.C.  
 Main 25335 St. Mary