


LOTS 7 & 8, BLOCK 3.

ST. PIERRE & LT
LAWTON'S ADD.

JOHN B. IRVINE, SURVEYOR.
408 GLOBE BLDG.
ST. PAUL, MINN.
OCT. 24-1910.
SCALE 20 ft per inch.

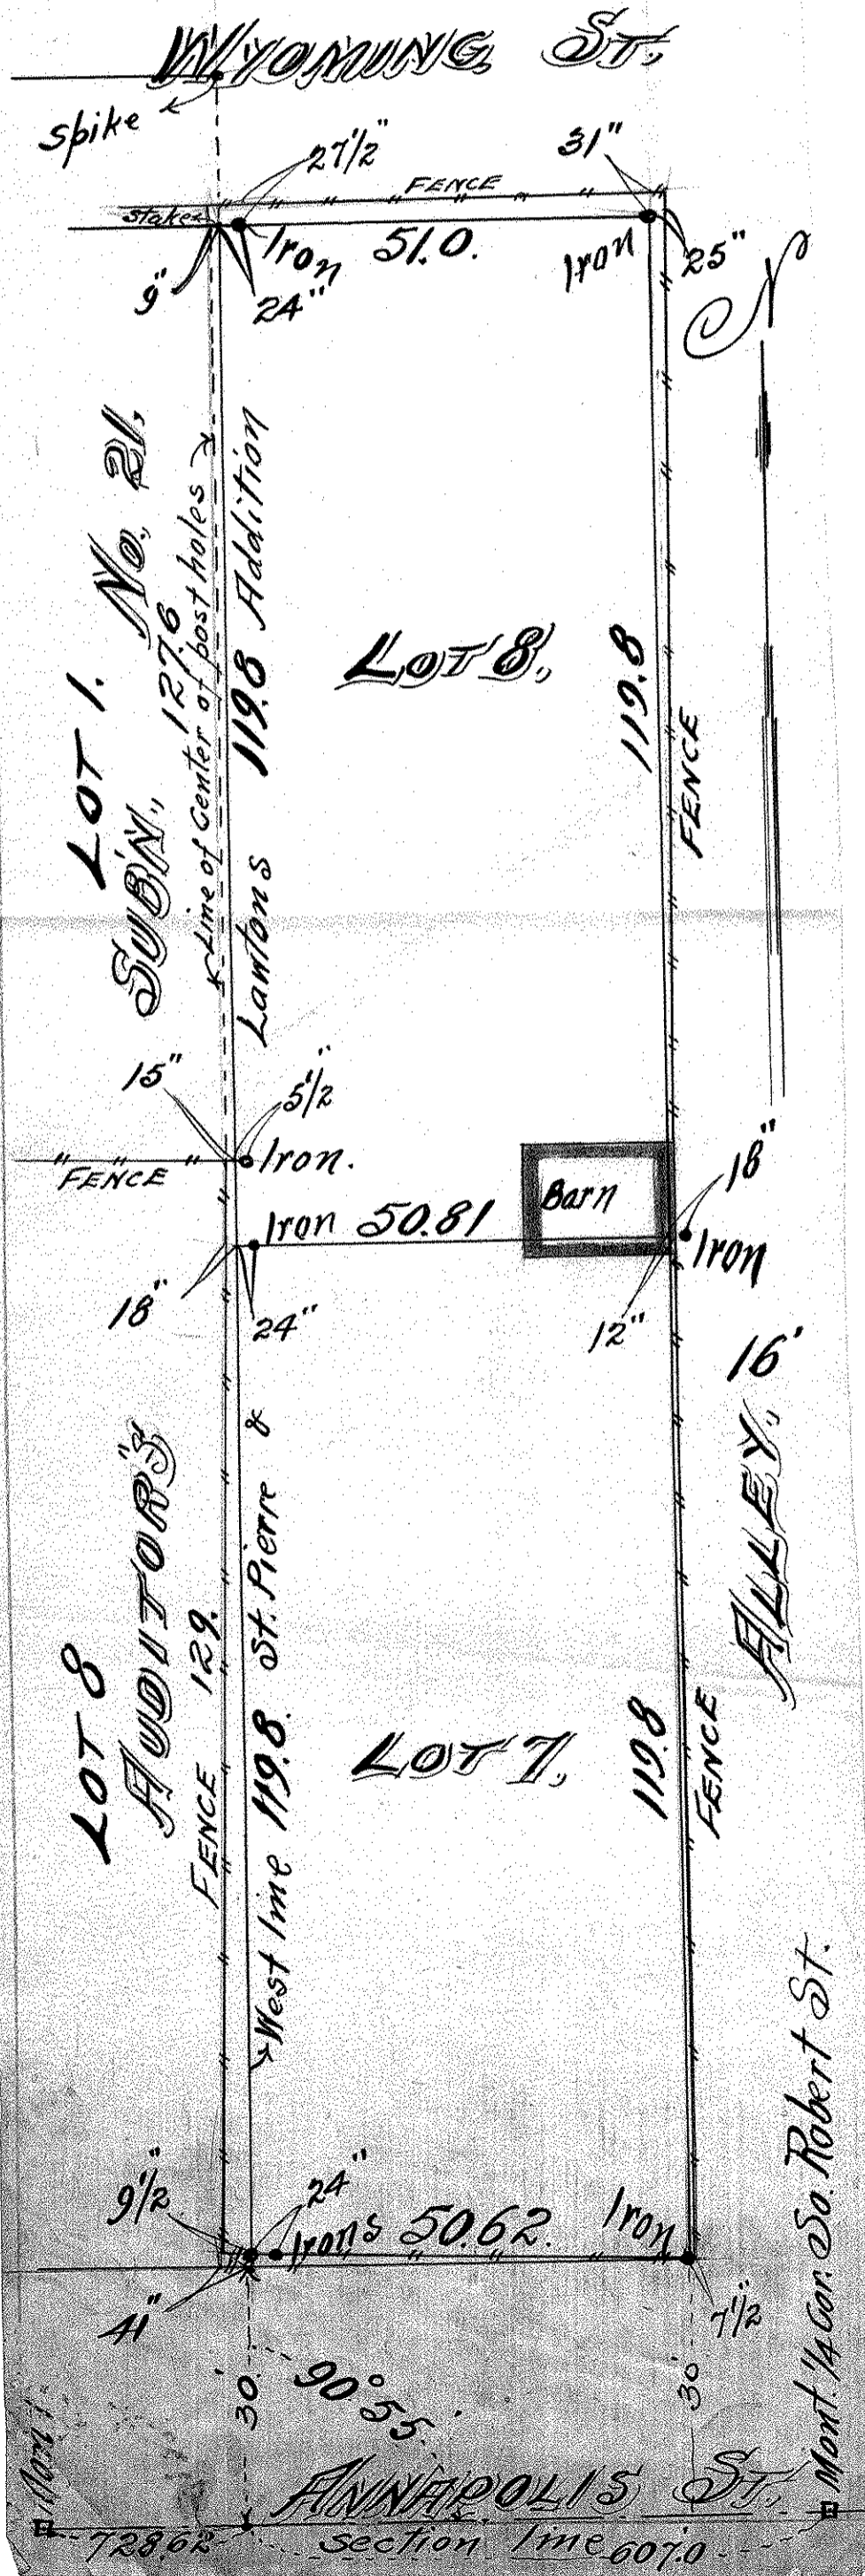

LOT 1, No. 21.
SUBD., 1276
Line of center of post holes
Lawton's 119.8 Addition

LOT 8
AUDITOR'S
FENCE 129.

LOT 8,

LOT 7,

ALLEY, 16'

ANNAPOLIS ST.
section 1 me 607.0

Mont 1/4 Cor. So. Robert St.