LOTS 1, 2, 3 & 6

SCHERER'S SUB No 1.

LOT 3 BLOCK 2.

ROGERS & HENDRICK'S ADD.

OF ACRE LOTS No 2.

John B. Irvine Surveyor.

Sept 20. 1920.
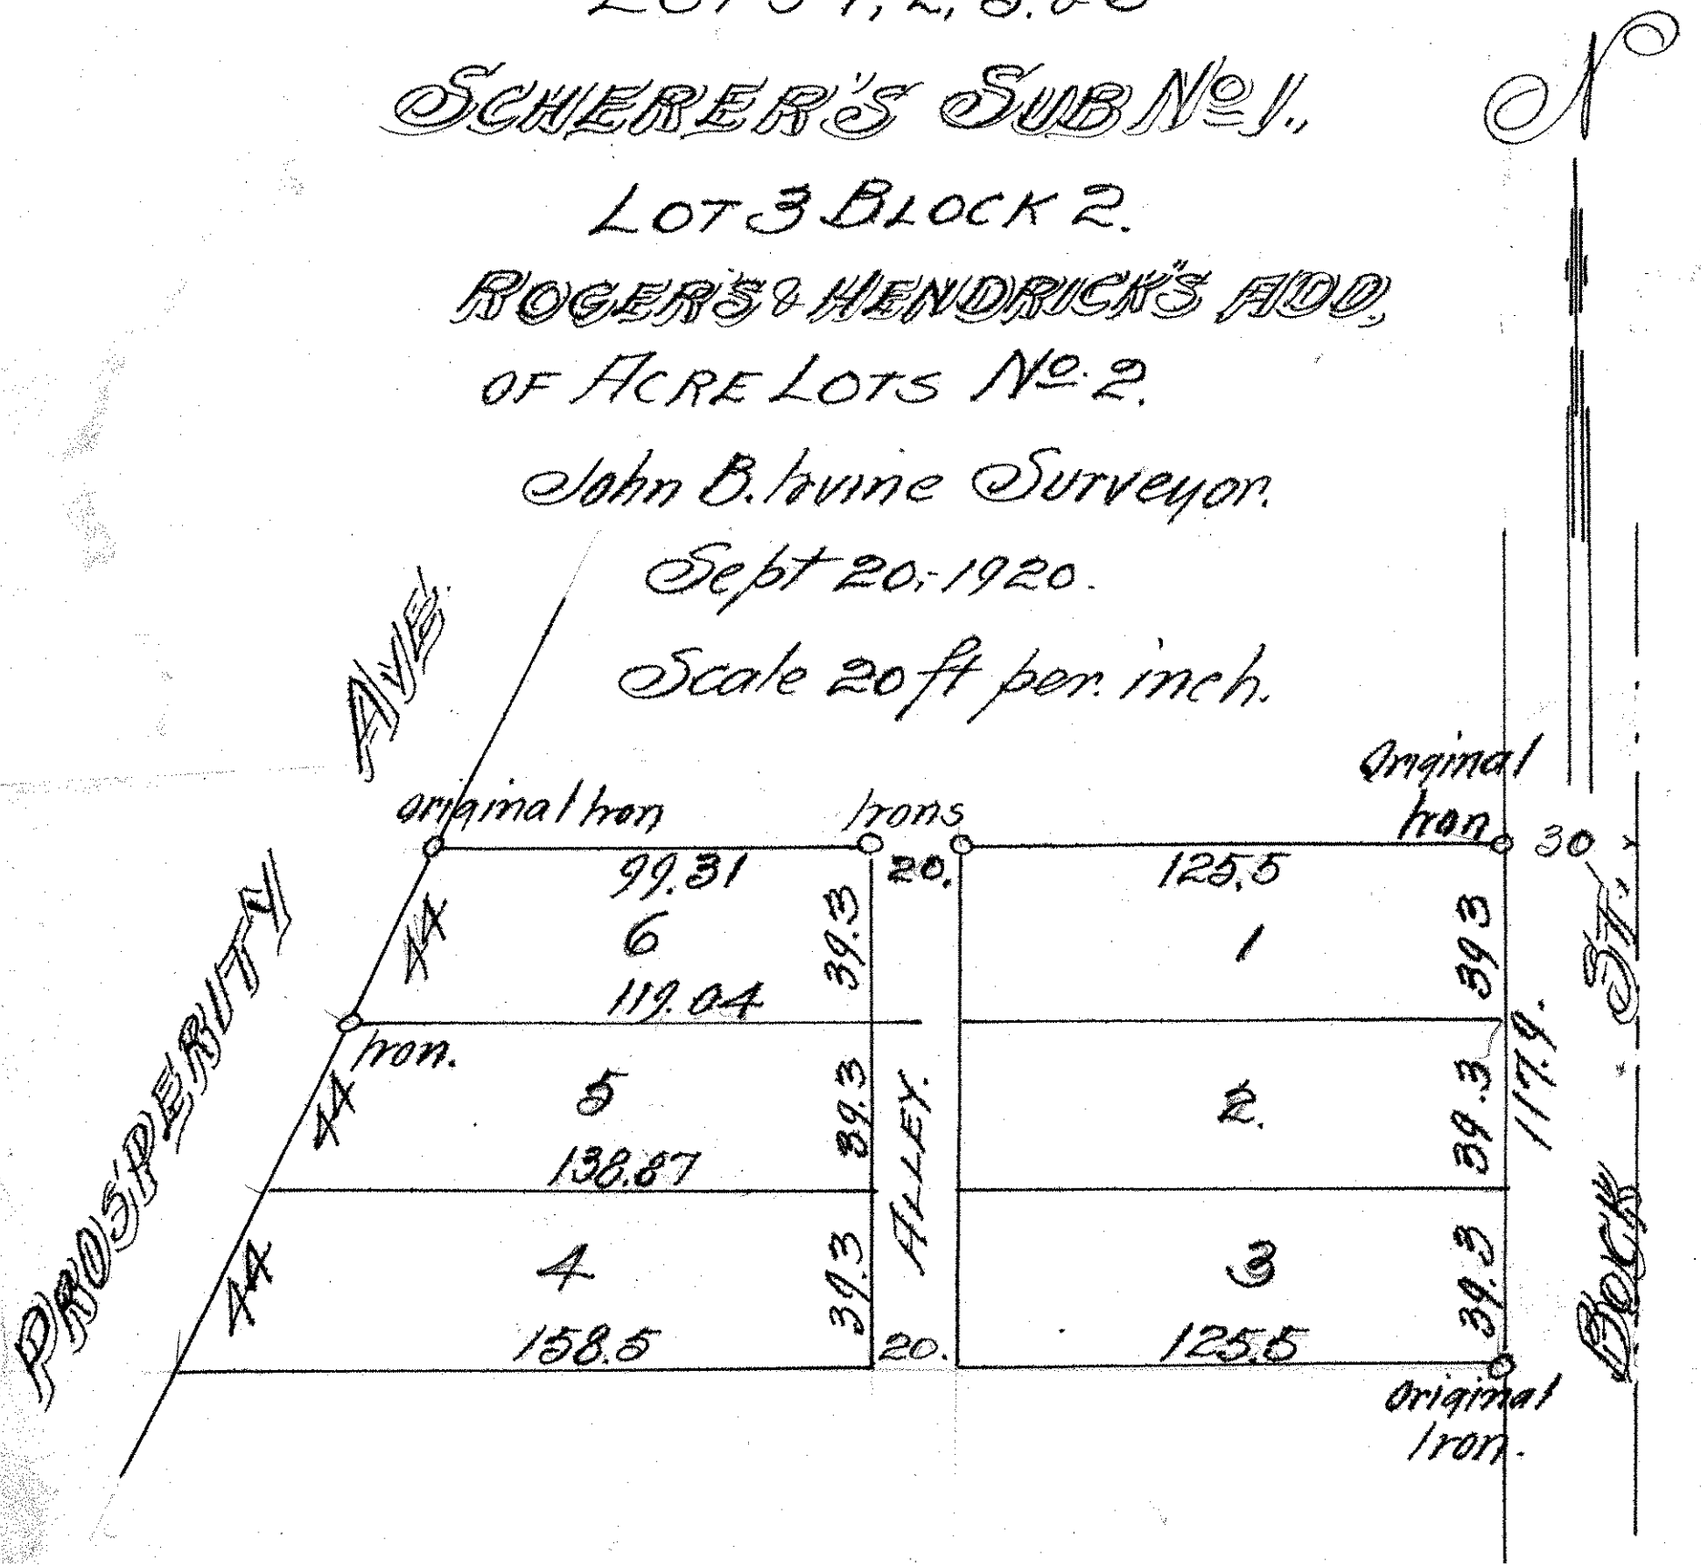
Scale 20 ft per inch.