

SW 24 29 23

From the office of  
**GEORGI. SCHMIDT & ASSOC. INC.**  
3092 No. Lexington Ave., Roseville, Mn. 55113  
LAND SURVEYING  
483-4408

**Certificate  
of Survey**

I Hereby Certify that this plat shows a survey made by me of the property described on this plat, and that the corners are correctly placed as shown, that this survey, plan or report was prepared by me, or under my direct supervision; and that I am a duly registered Land Surveyor under the Laws of the State of Minnesota.

Job Number: 3707


Surveyed For BACCHOS-KIGHT

Date 10/05/88

Scale 1" = 30'

BY \_\_\_\_\_  
REGISTERED LAND SURVEYOR  
Mn. Registration No. 10459

Description of Lot 8 and Lot 9, Schletti Addition,  
RAMSAY COUNTY, Minnesota

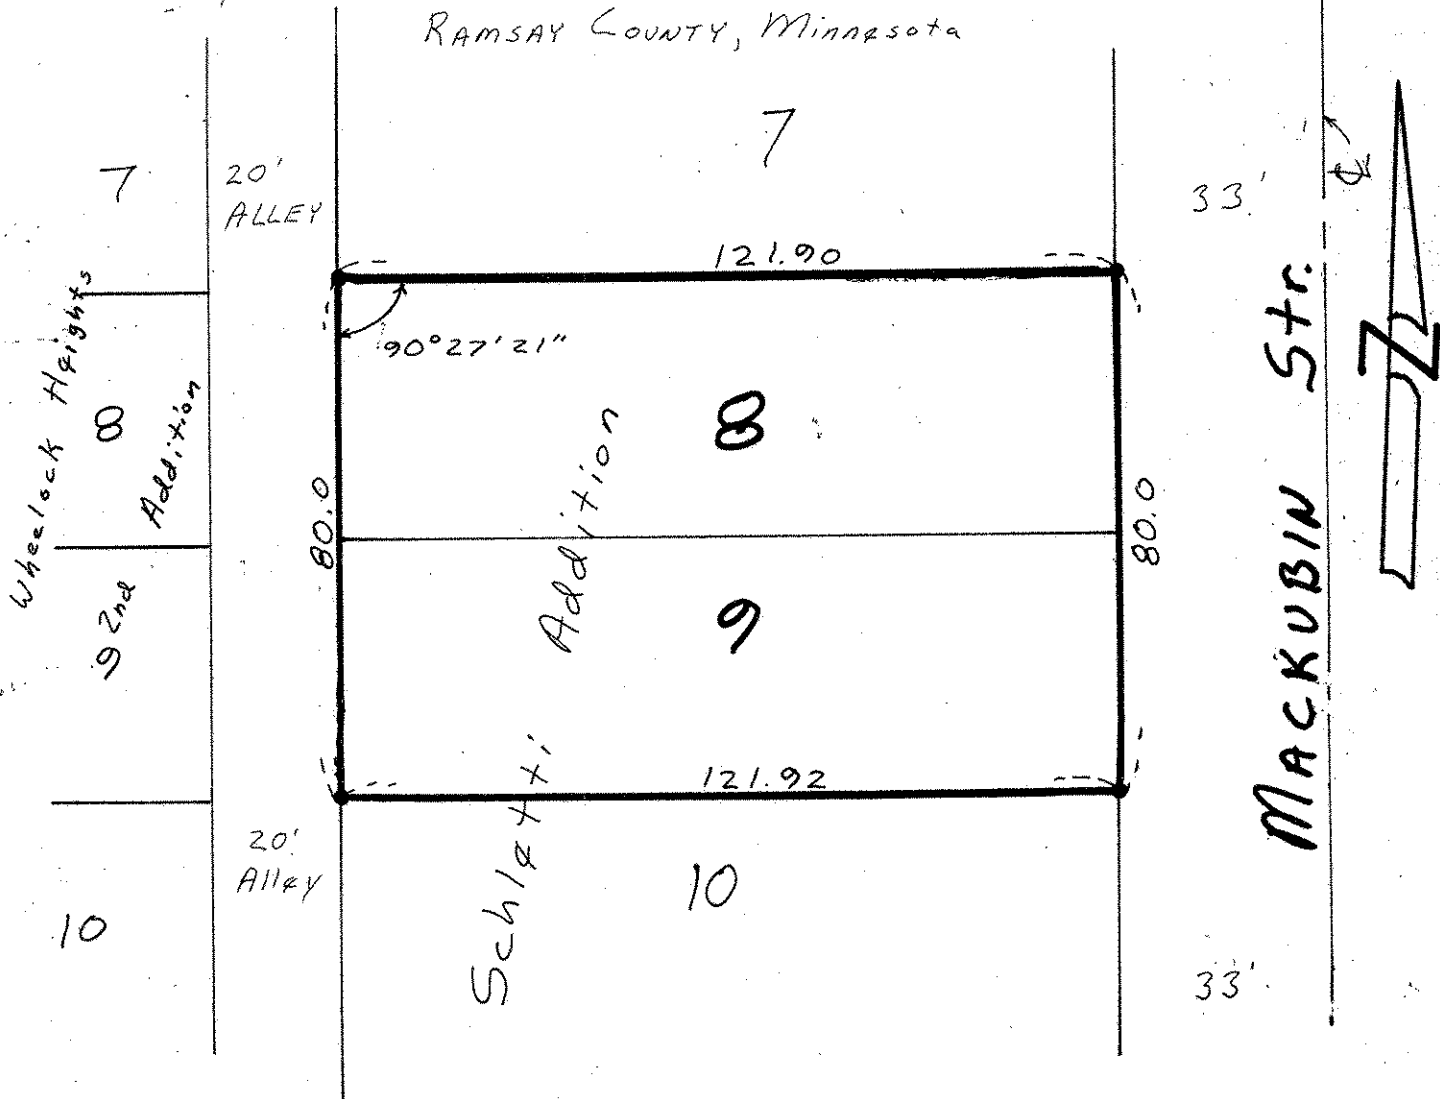

KEY  
● = Iron Found