


LOT 6 BLOCK 3
SCHROEDER'S ADD.

JOHN B. IRVINE. SURVEYOR.
408 GLOBE BLDG.
ST. PAUL, MINN.
APRIL 22-1916.

Scale 20ft per inch.

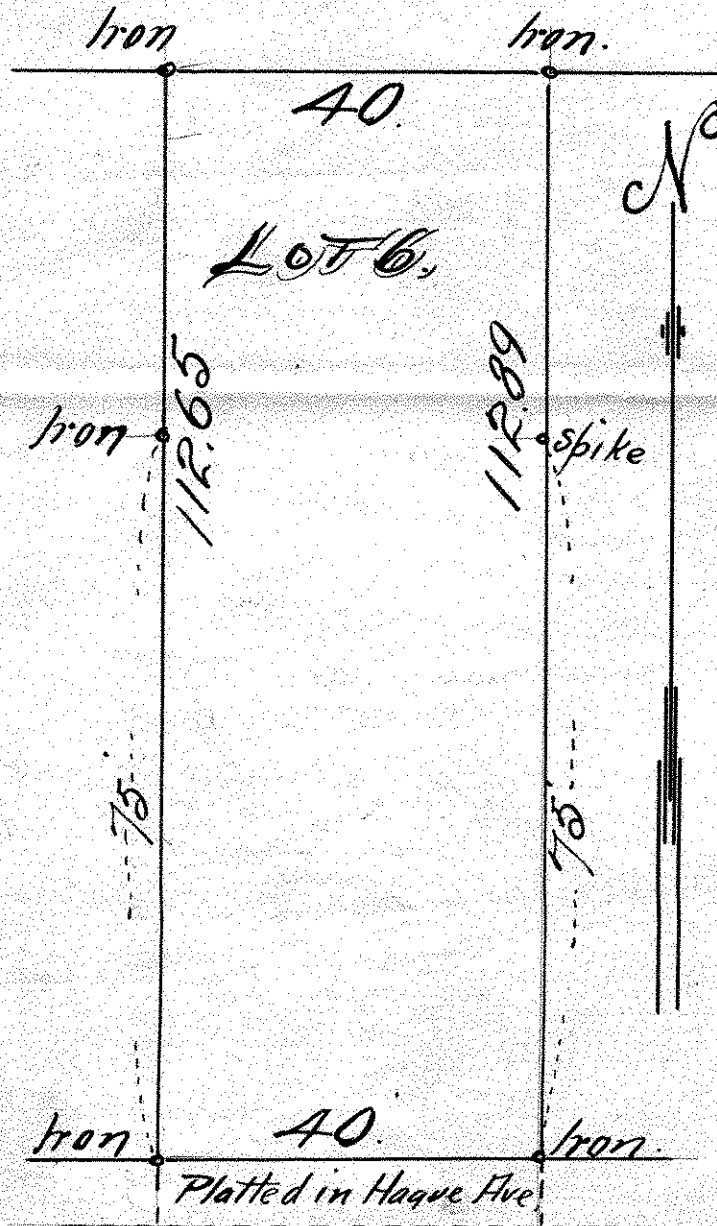

HAGUE AVE.