

LOT 18 & ELY 21 ft. LOT 17

BLOCK 8

SCHROEDER'S ADD.


JOHN B. IRVINE, SURVEYOR. N

408 GLOBE BLDG.

ST. PAUL, MINN.

APRIL 15-1914

Scale 20 ft. per inch.

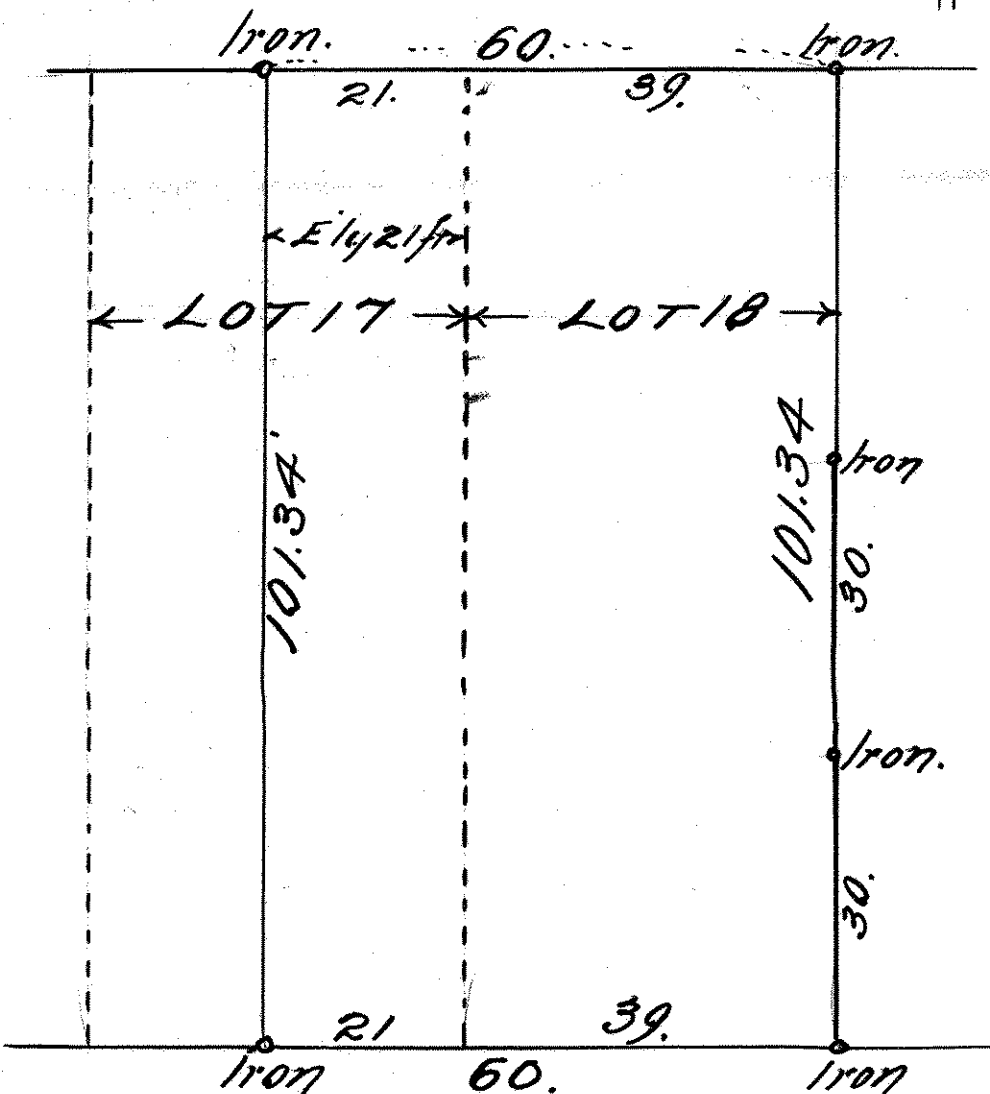

LAUREL AVE.