

LOT 12 BLOCK 12.

SCHROEDER'S ADD.

J. B. Irvine, Surveyor.


LAUREL AVE.

S.W.K.  
223.26

Curb  
+221.52

222.26  
S.W.K.

AVE.

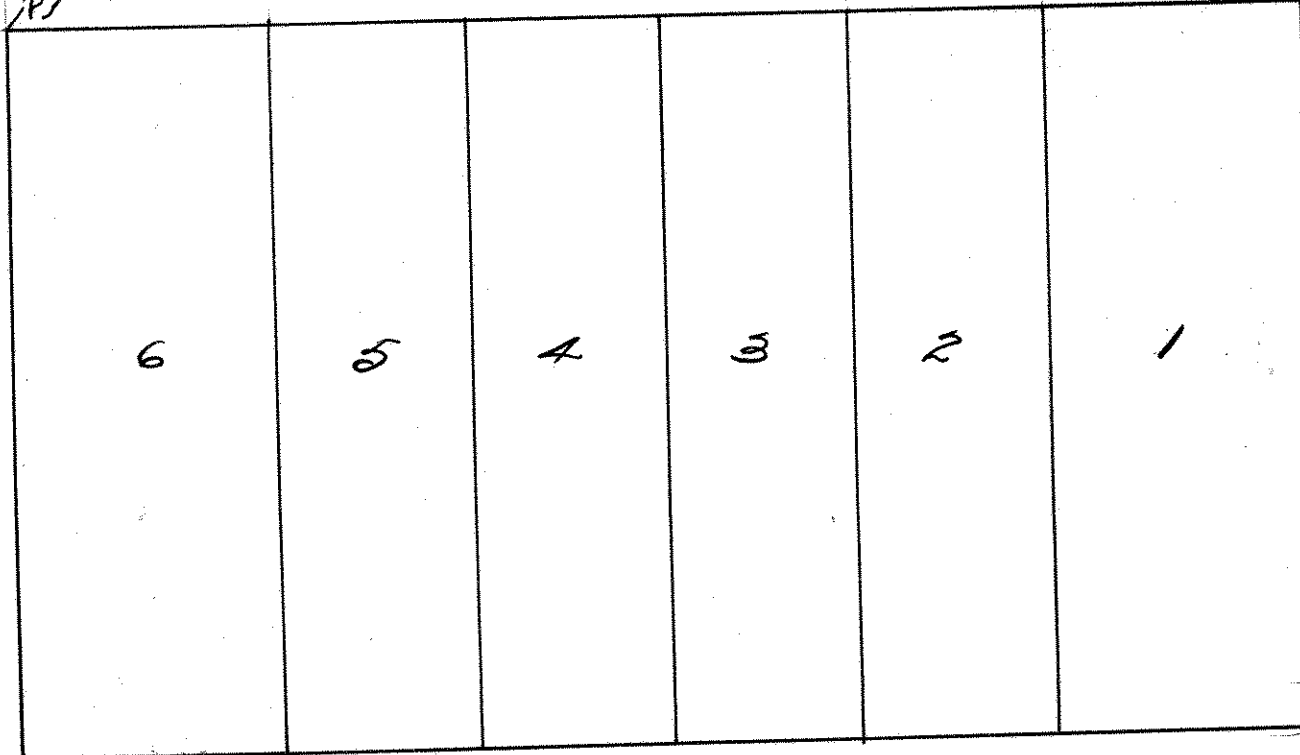

S.F.

Mean.  
+221.26

+221.10  
Mean.


12.

Iron.

Iron

Iron

HERSCHEL

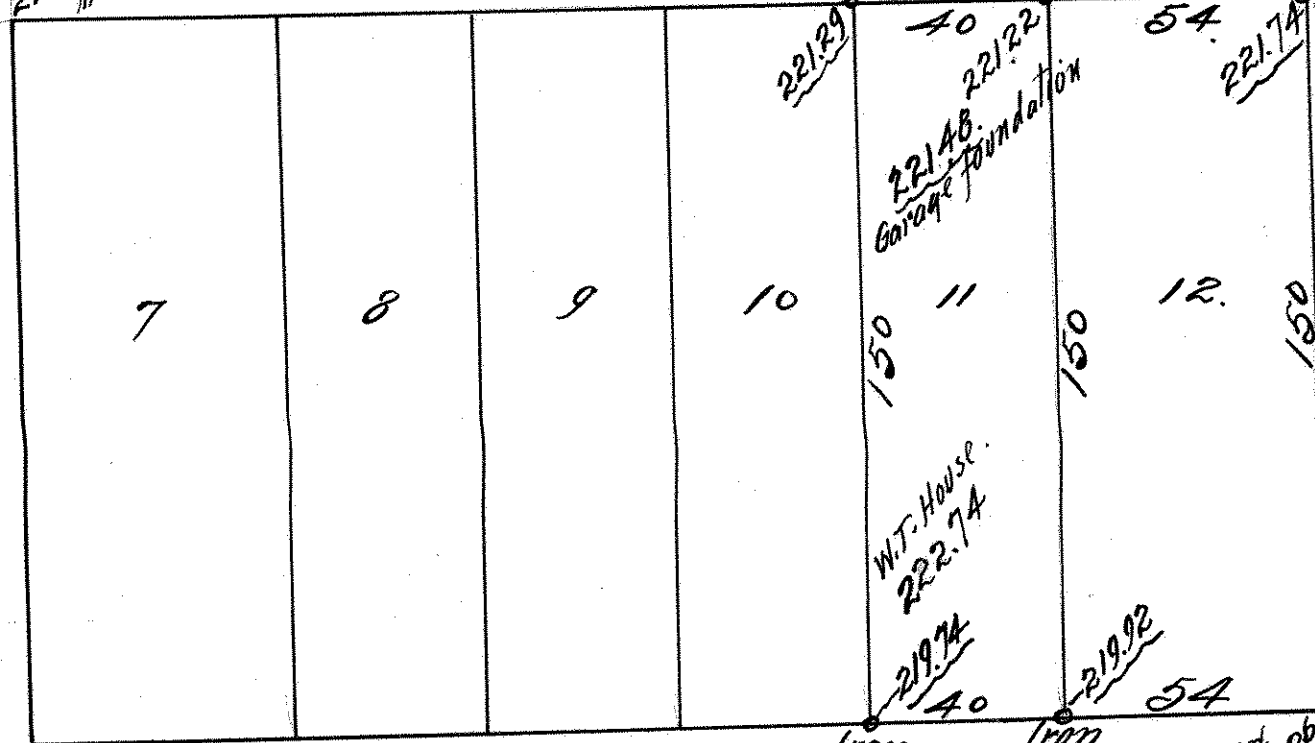

ASHLAND

S.W.K.  
218.94

scale 40'=1"  
April 3-1914

ASHLAND AVE.

Elev.  
220.26  
S.W.K.