

LOT 11 & WEST 10ft LOT 12
BLOCK 17
SCHROEDER'S ADD.


JOHN B. IRVINE, SURVEYOR.

ST. PAUL, MINN.

SCALE 20ft per inch.

OCT. 21-1908.

STAKE 50 ALLEY 20
40. 10 STAKE

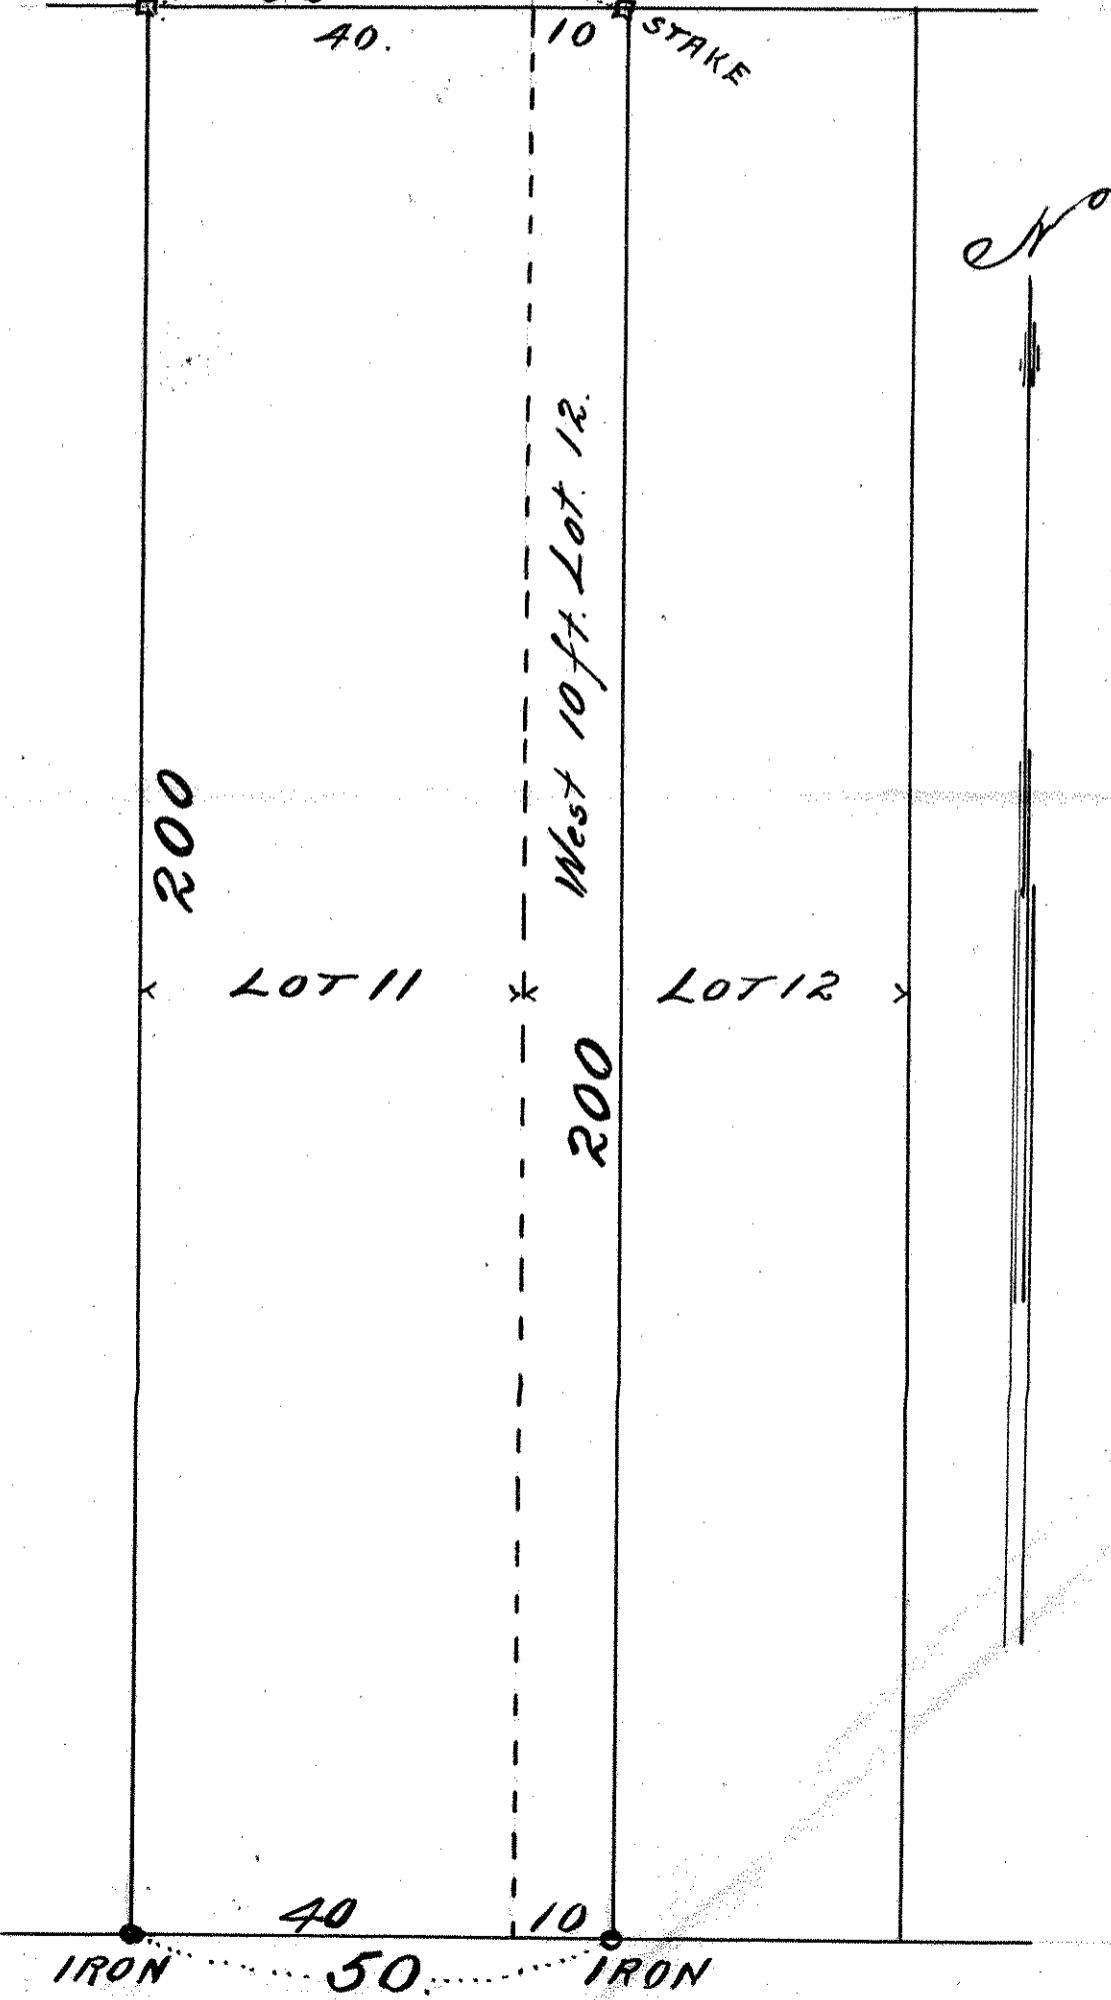

SUMMIT AVE.