

LOT 11 BLOCK 12.

SCHROEDER'S ADD.

JOHN B. IRVINE, SURVEYOR.

408 GLOBE BLDG.

ST. PAUL, MINN.

MARCH 9-1914.

SCALE 20 ft. per inch.

ALLEY

Iron.


Iron.

40.

LOT 11.

33 1/2" 150.

150.

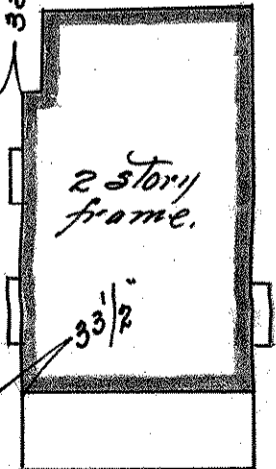

Iron

Iron.

FISHLAND AVE.

MARCH - 1914