


LOTS 1 & 2 BLOCK 14
SCHROEDER'S ADD.

JOHN B. IRVINE, SURVEYOR.
408 GLOBE BLDG.
ST PAUL MINN.
MAY 21-1909
SCALE 20 ft per inch

ASHLAND AVE.

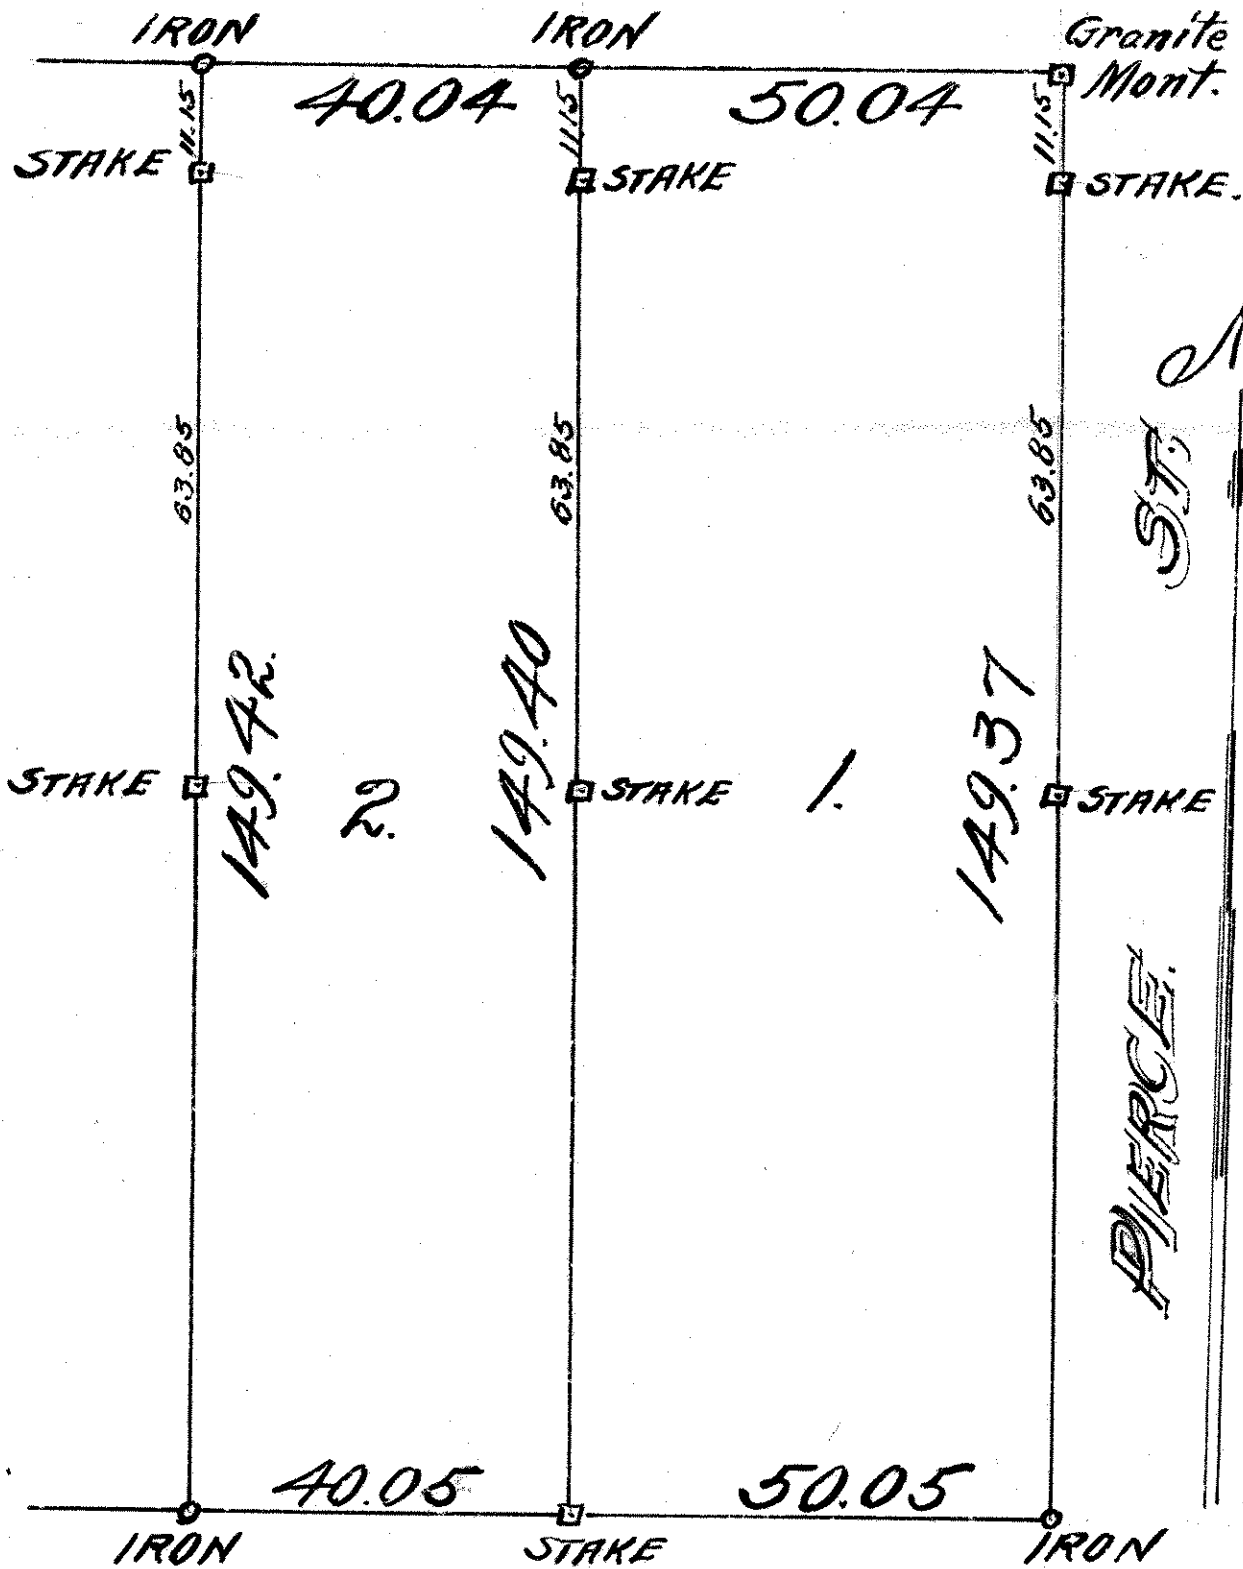

ALLEY.