

LOT 12 BLOCK 9

SCHROEDER'S


ADDITION,

JOHN B. IRVINE SURVEYOR,

JUNE 17-1906.

SCALE 20ft. per. inch.

LAUREL AVE.

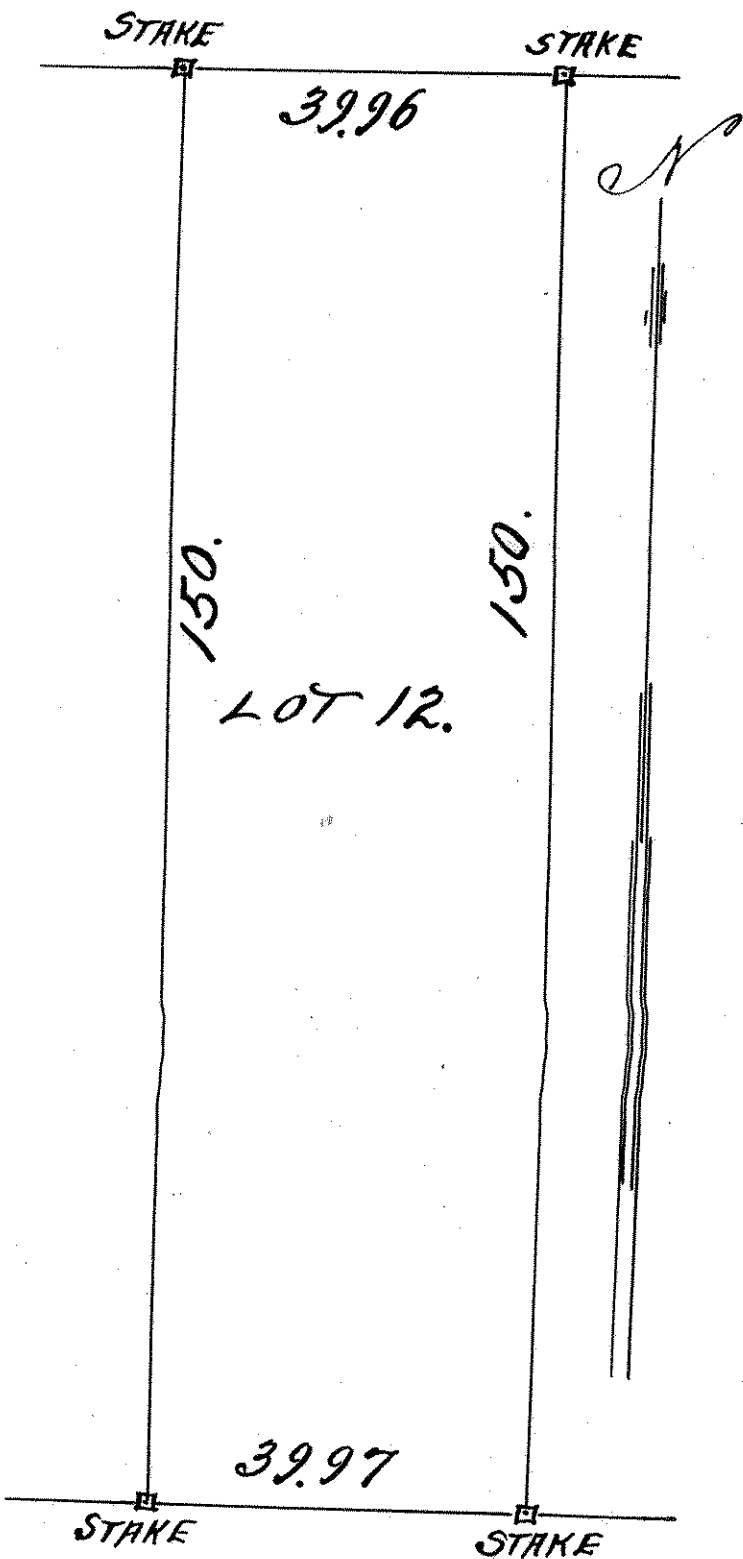

ALLEY, 20