


LOT 12 BLOCK 1. SCHROEDER'S ADD.

JOHN B. IRVINE, SURVEYOR.
285 MACKUBIN ST.
ST. PAUL, MINN.
MAY. 23-1918
Scale 20 ft. per inch.

FRY ST.

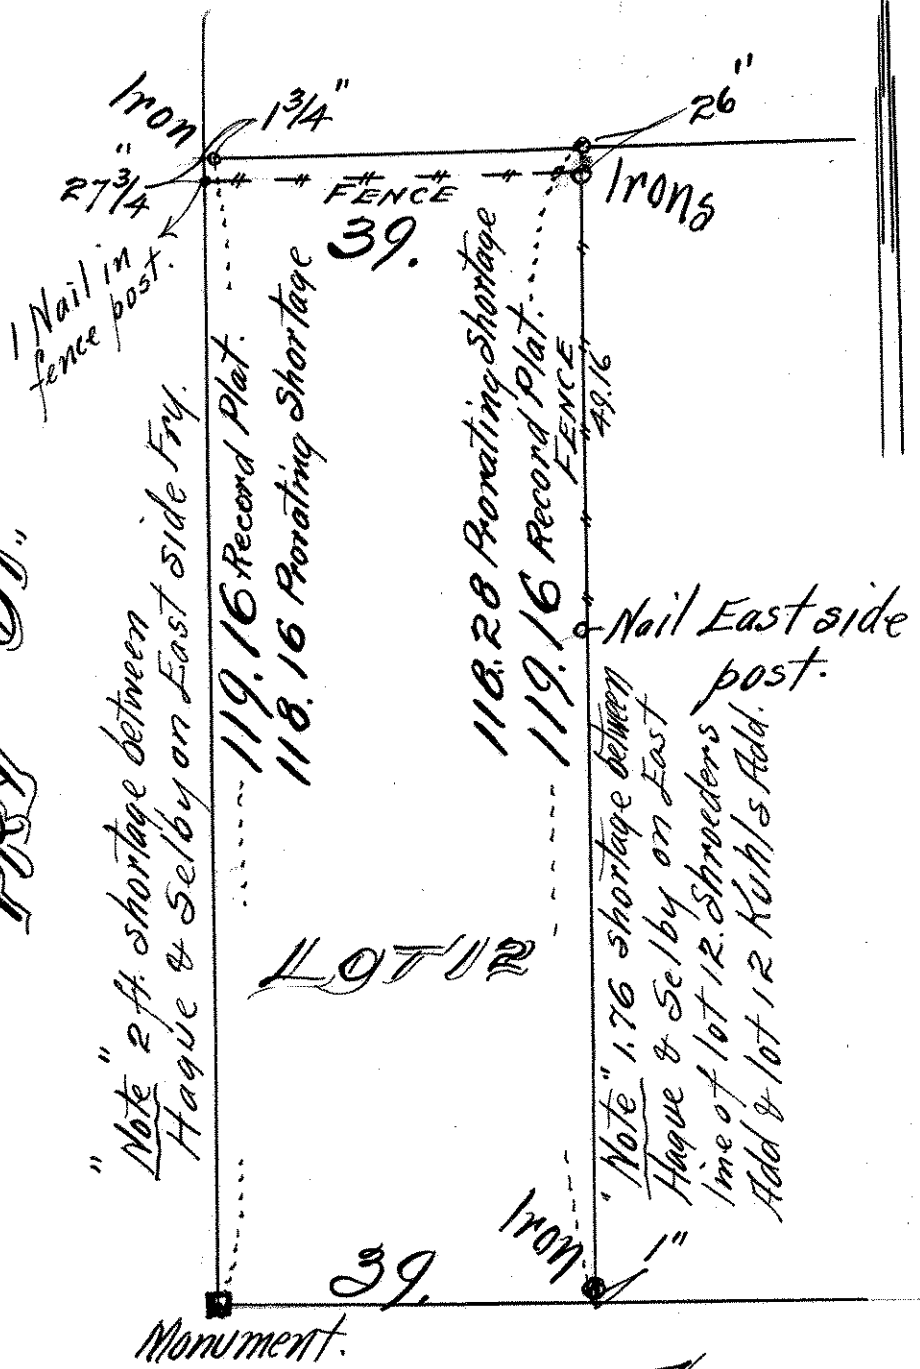

"Note" 2 ft. shortage between
Hague & Selby on East side Fry.

"Note" 1.76 shortage between
Hague & Selby on East
line of lot 12 Schroeders
Add & lot 12 Kuhls Add.

HAGUE AVE.