


Lot 30
SCOTTEN'S SUB.
BLOCK 71.
LYMAN DAYTON'S ADD.

JOHN B. IRVINE SURVEYOR.
ST PAUL MINN.
NOV. 4-1908.
SCALE 20 ft. per inch.

ALLEY, 20 ft.

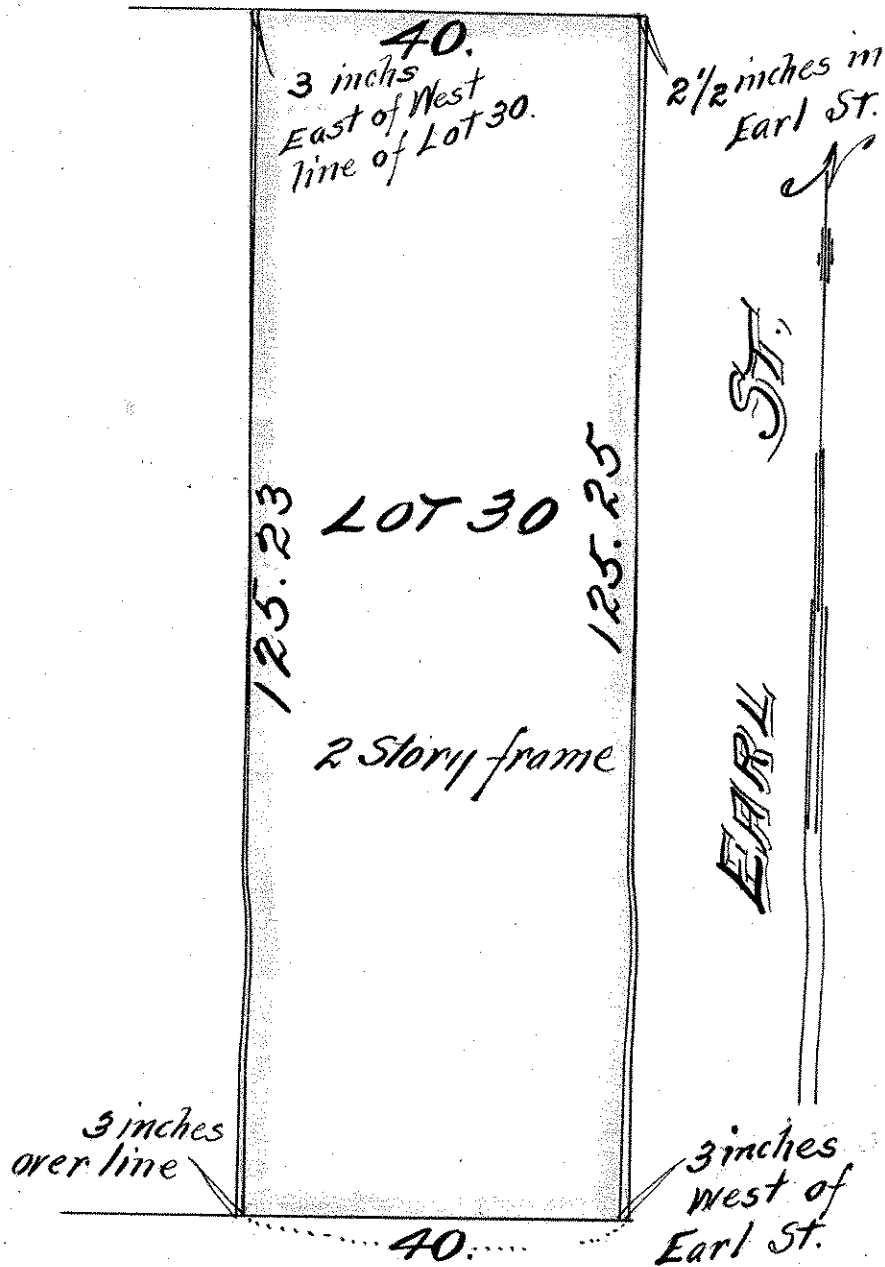

HASTINGS AVE.