


LOT 25 BLOCK 4  
H. F. SCHWABE'S  
ADDITION.

JOHN B. IRVINE, SURVEYOR.  
408 GLOBE BLDG.  
ST PAUL, MINN.  
OCT 13-1914  
scale. 20 ft. per. inch.

ALLEY 20'

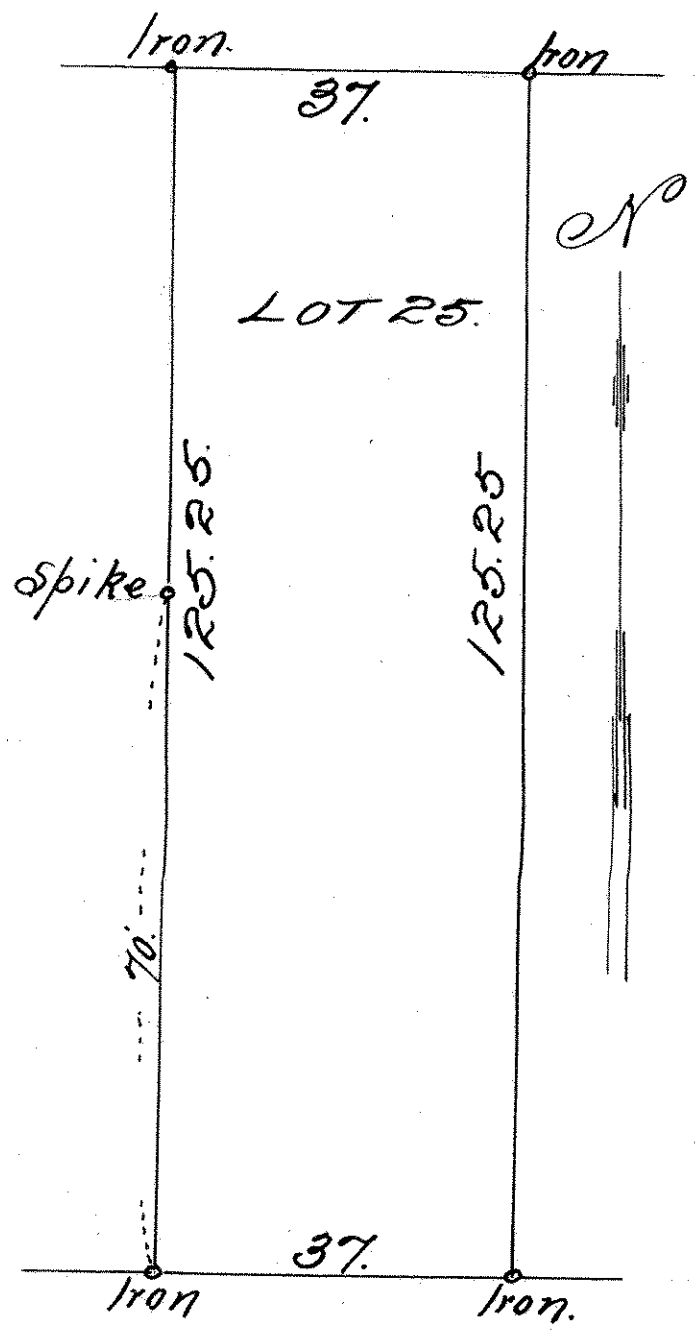

HASTINGS AVE.