


LOT 10 BLOCK 2  
SCHWABE'S ADD.  
20 FT. PR. INCH.

EUCLID ST.

stake

37.00

stake

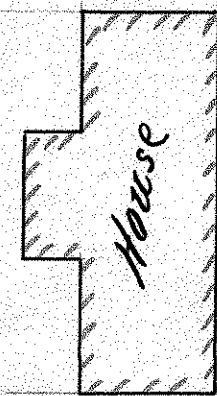

SP

126.35

126.35



stake

37.

stake

Alley 20

J. Thompson  
Apr. 23<sup>rd</sup> 1903