

LOT 12. BLOCK 8

H.F. SCHWABE'S

ADDITION

JOHN B. IRVINE, SURVEYOR.


408 GLOBE BLDG.

ST. PAUL, MINN

MAY 26-1911

SCALE 20 ft. per inch.

CONWAY ST.

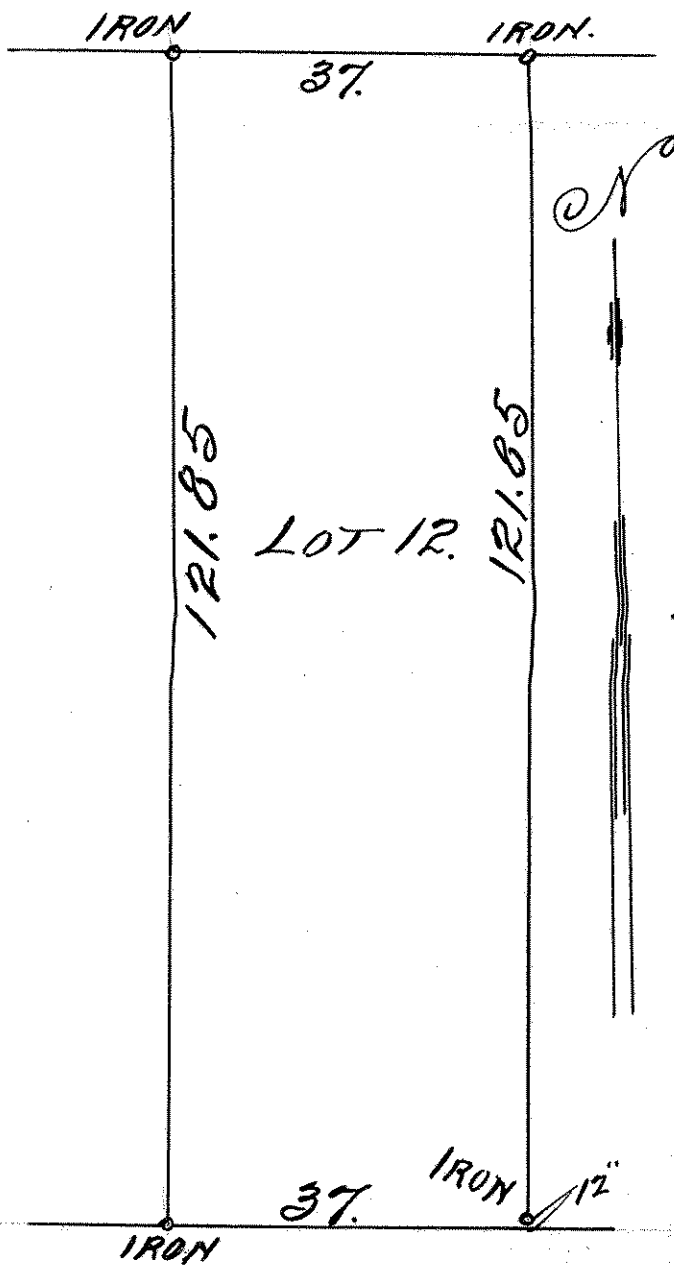

ALLEY 2