LOT 4 BLOCK 4
H.F. SCHWABE'S ADDITION.
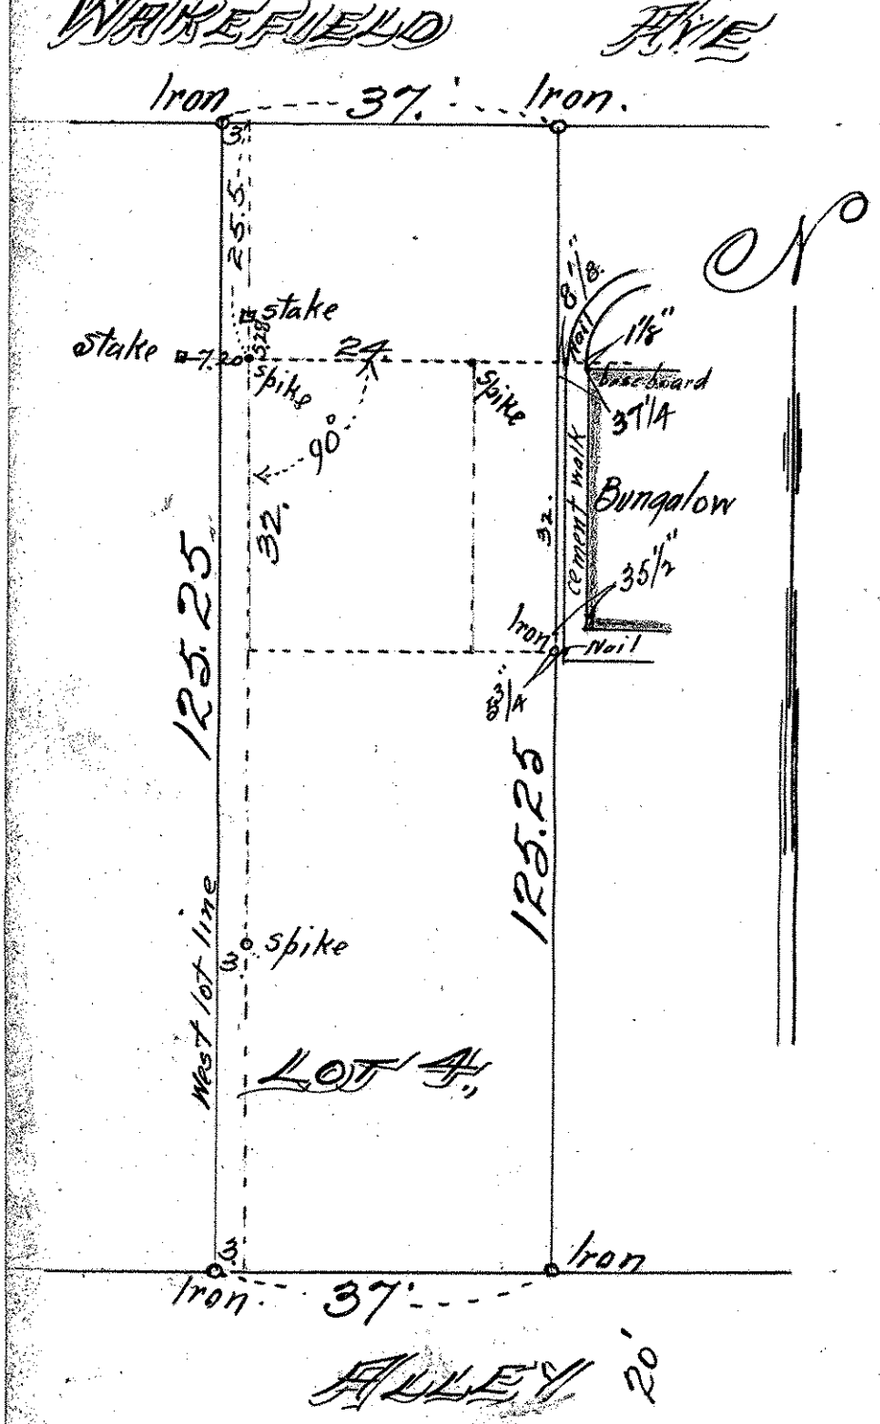
JOHN B. IRVINE, SURVEYOR.
285 MACKUBIN ST.
ST. PAUL, MINN.
MARCH 21-1919
Scale 20 ft. per inch.