


LOTS 10, 11 & 12 BLOCK 1  
SELBY M<sup>c</sup>CLUNG & VAN METER'S ADD.

JOHN B. IRVINE SURVEYOR.  
416 GLOBE BLDG.  
ST PAUL MINN.  
OCT 11-06.

SCALE 1 IN. = 20 FT.

MARSHALL AVE.

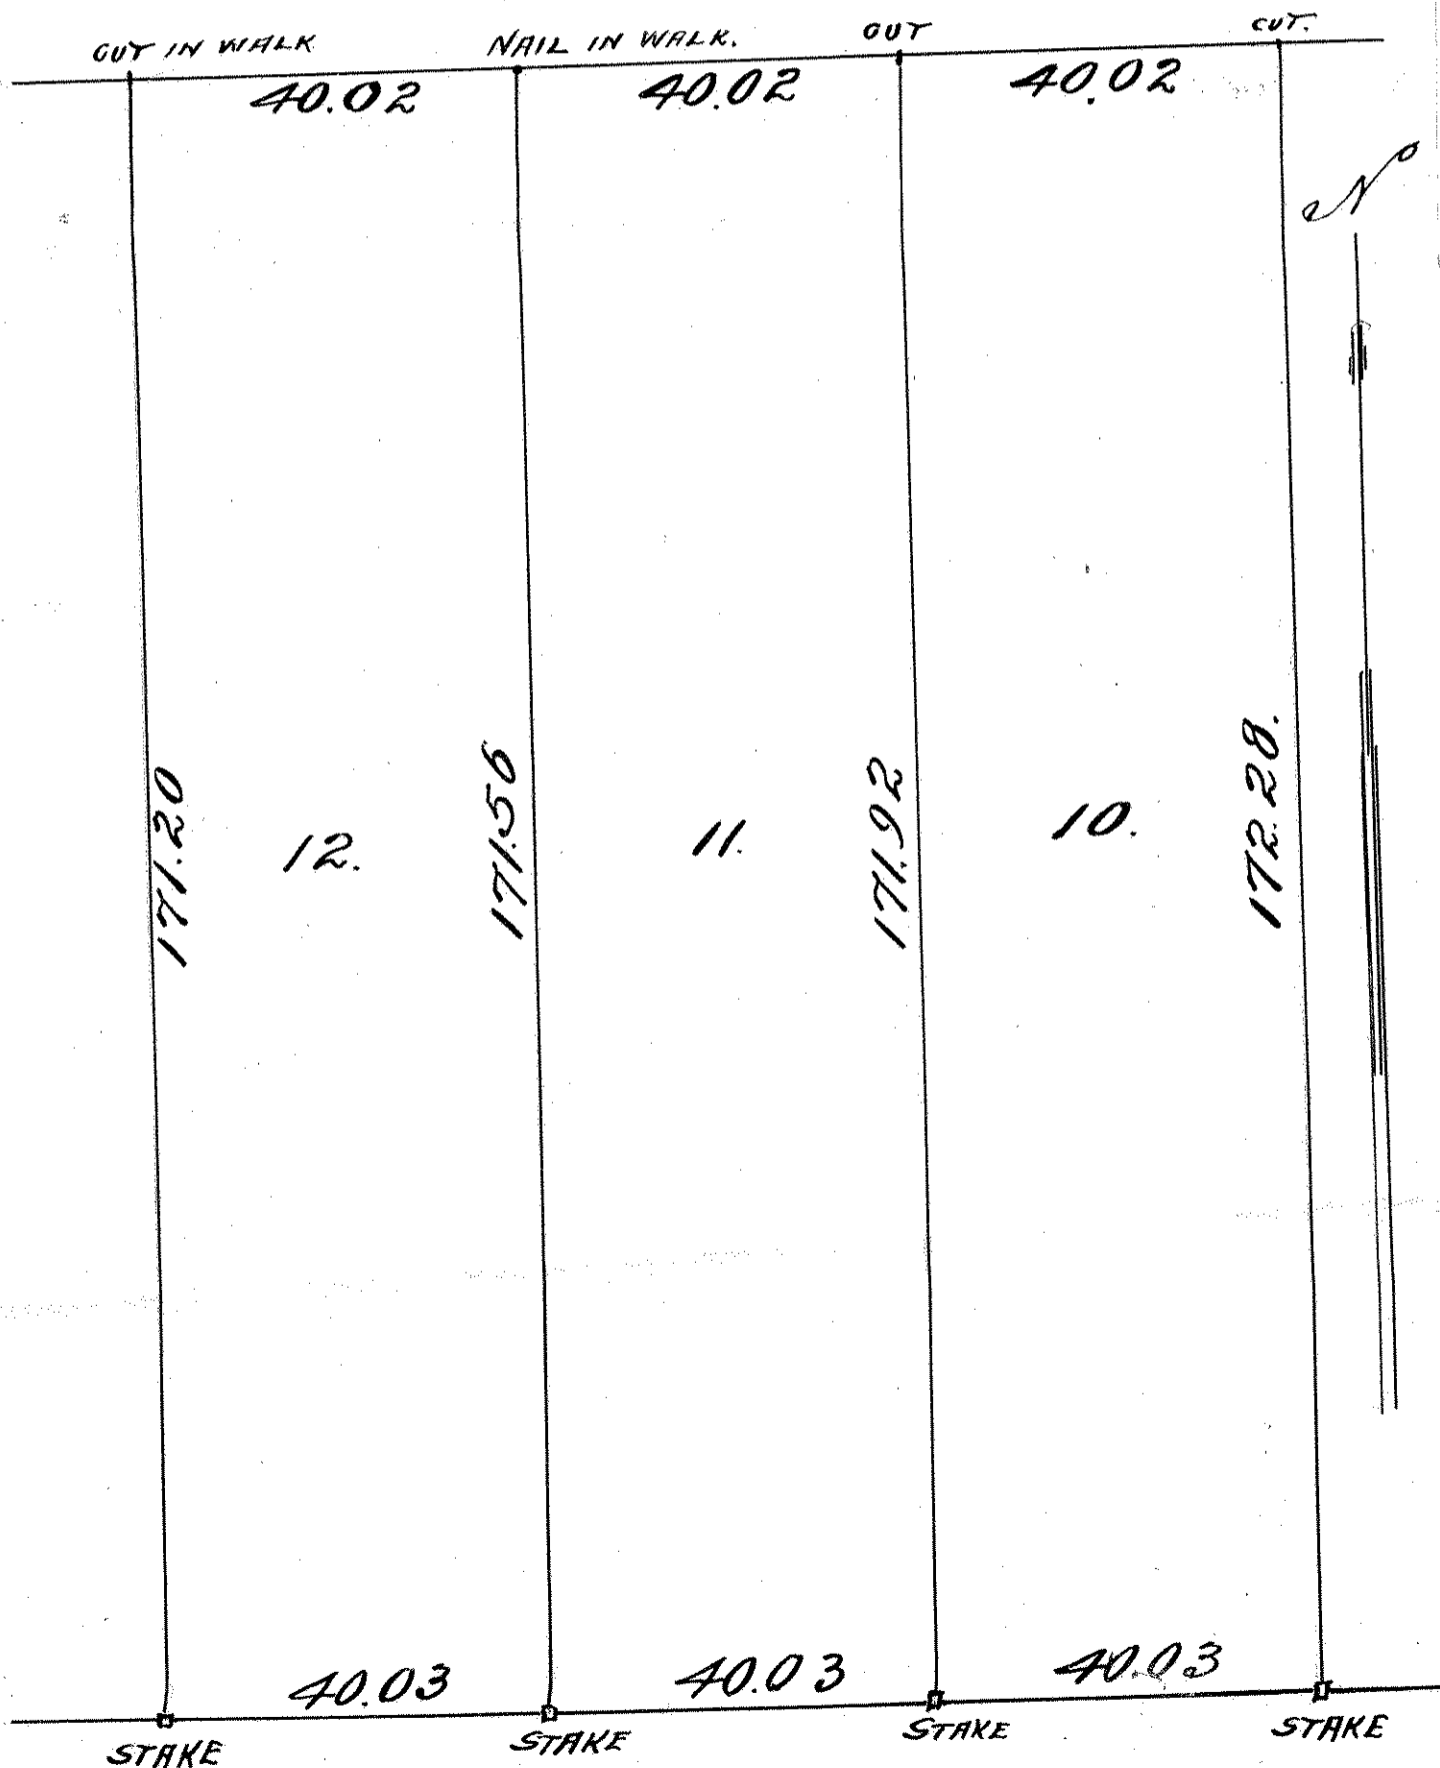

ALLEY