


I hereby certify to having located the two story dwelling house on lot 1 block two Selby, McClung and Van Meters Add. to St Paul, Minn. as shown on this map and the same is correct.

John B. Irvine.

February 1914.

Surveyor.

DAYTON AVE.

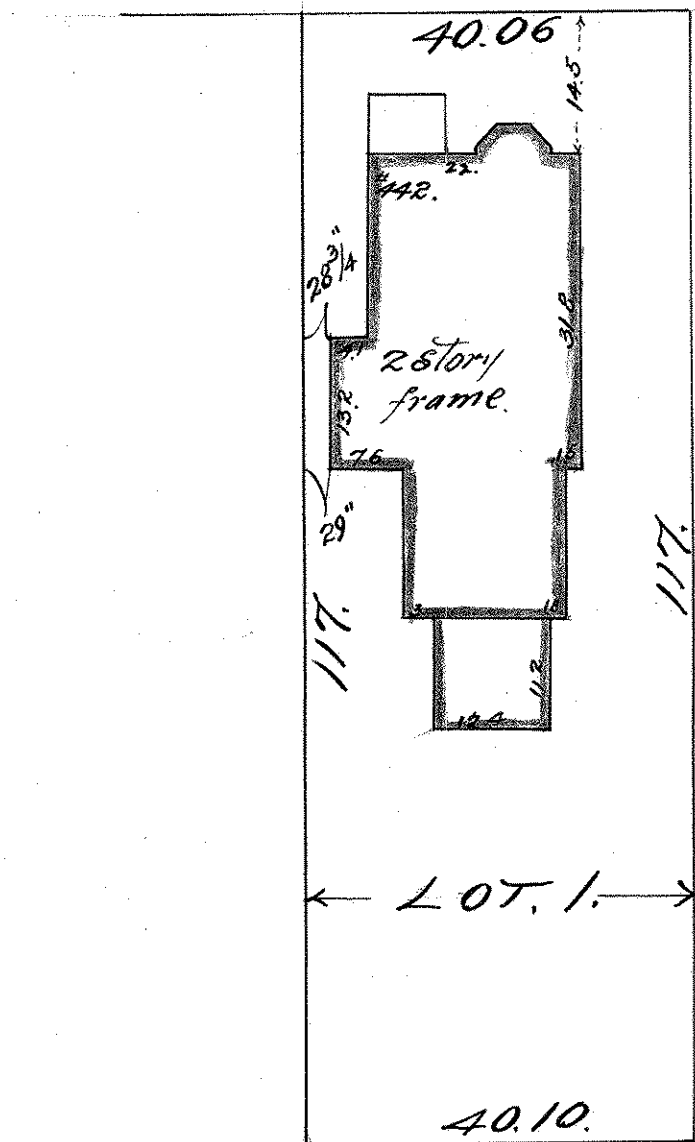

ROUND ST.