


Aug 1901

# LOT 22 BLOCK 1 SELBY, M<sup>c</sup>CLUNG & VAN METER ADDITION

SURVEYED BY  
**JOHN B. IRVINE**  
ROOM 16 COURT HOUSE

scale 20 ft. per inch

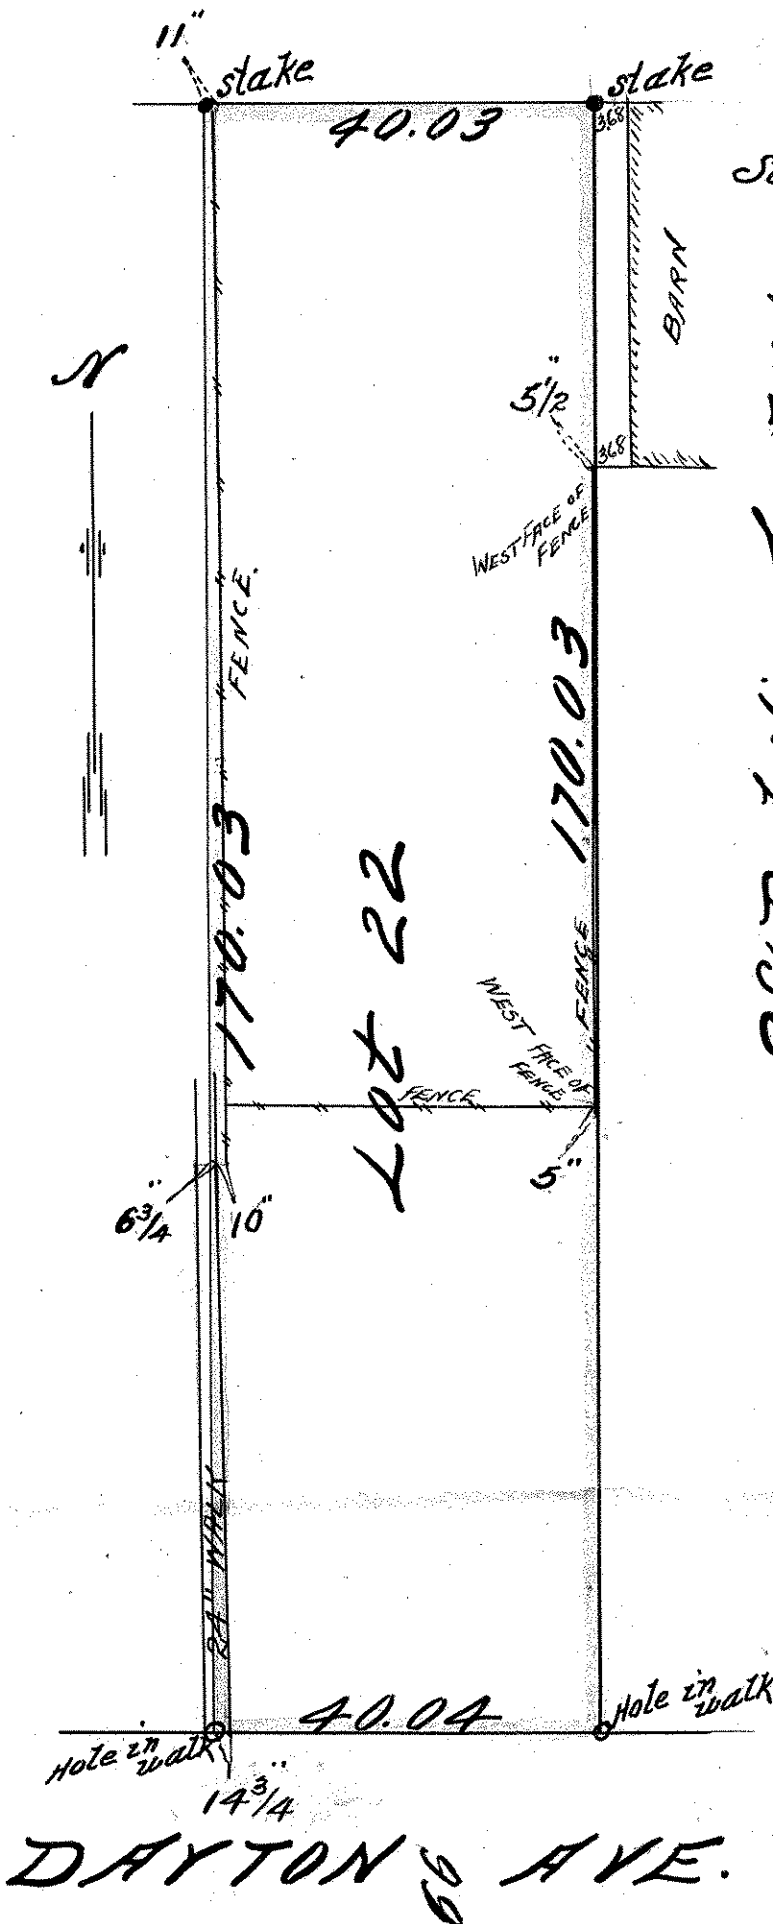

St. Paul Minn. Aug. 17, 1901

I, hereby certify that this diagram correctly represents LOT 22 BLOCK 1, SELBY, M<sup>c</sup>CLUNG & VAN METER'S ADDITION as surveyed by me this day.

John B. Irvine  
County Surveyor.

Dec. 14-1907 I have this day verified this survey.

John B. Irvine.

DAYTON AVE.  
66