

# CHARLES O. GEORGI COMPANY

2215 West County Road B

Saint Paul, Minnesota 55113

REGISTERED CIVIL ENGINEER AND LAND SURVEYOR



## Certificate of Survey

I Hereby Certify that this plat shows a survey made by me of the property described on this plat, and that the corners are correctly placed as shown, and that all locations have been correctly shown.

Surveyed For Housing Authority

Date January, 1971

Scale 1" = 40'

By Charles O. Georgi  
REGISTERED LAND SURVEYOR

# 470 Marshall


Description:

Lot 8, Block 1, Selby McClung & Van Meter's Addition,  
St. Paul, Ramsey County, Minnesota.

66

MARSHALL AVE.

66

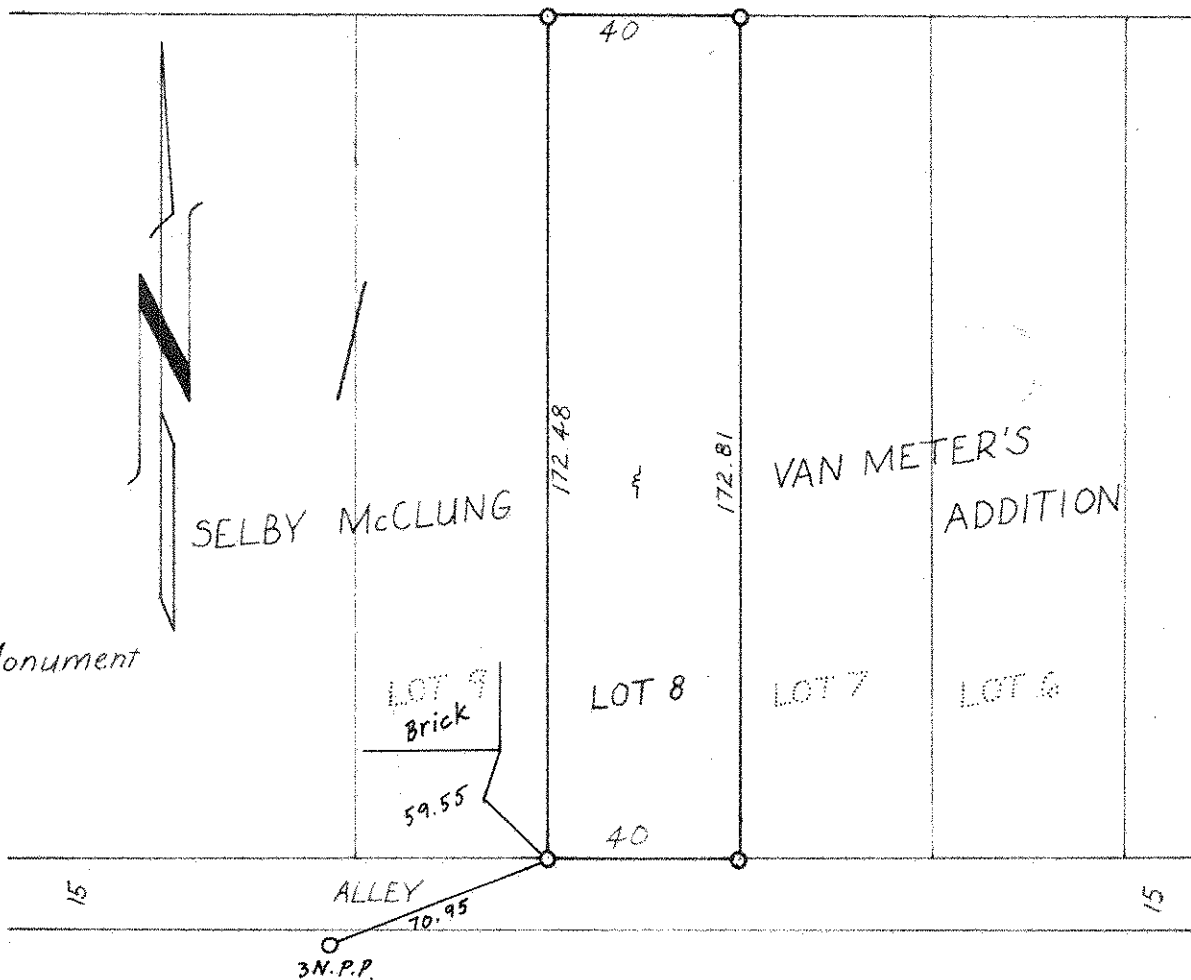

○ Denotes Iron Pipe Monument