


LOTS 16 & 17 BLOCK 2.

SELBY, McCLUNG & VAN METER'S ADD.

John B. Irvine, Surveyor.

Aug. 31, 1921.

Scale. 10 ft. per. inch.

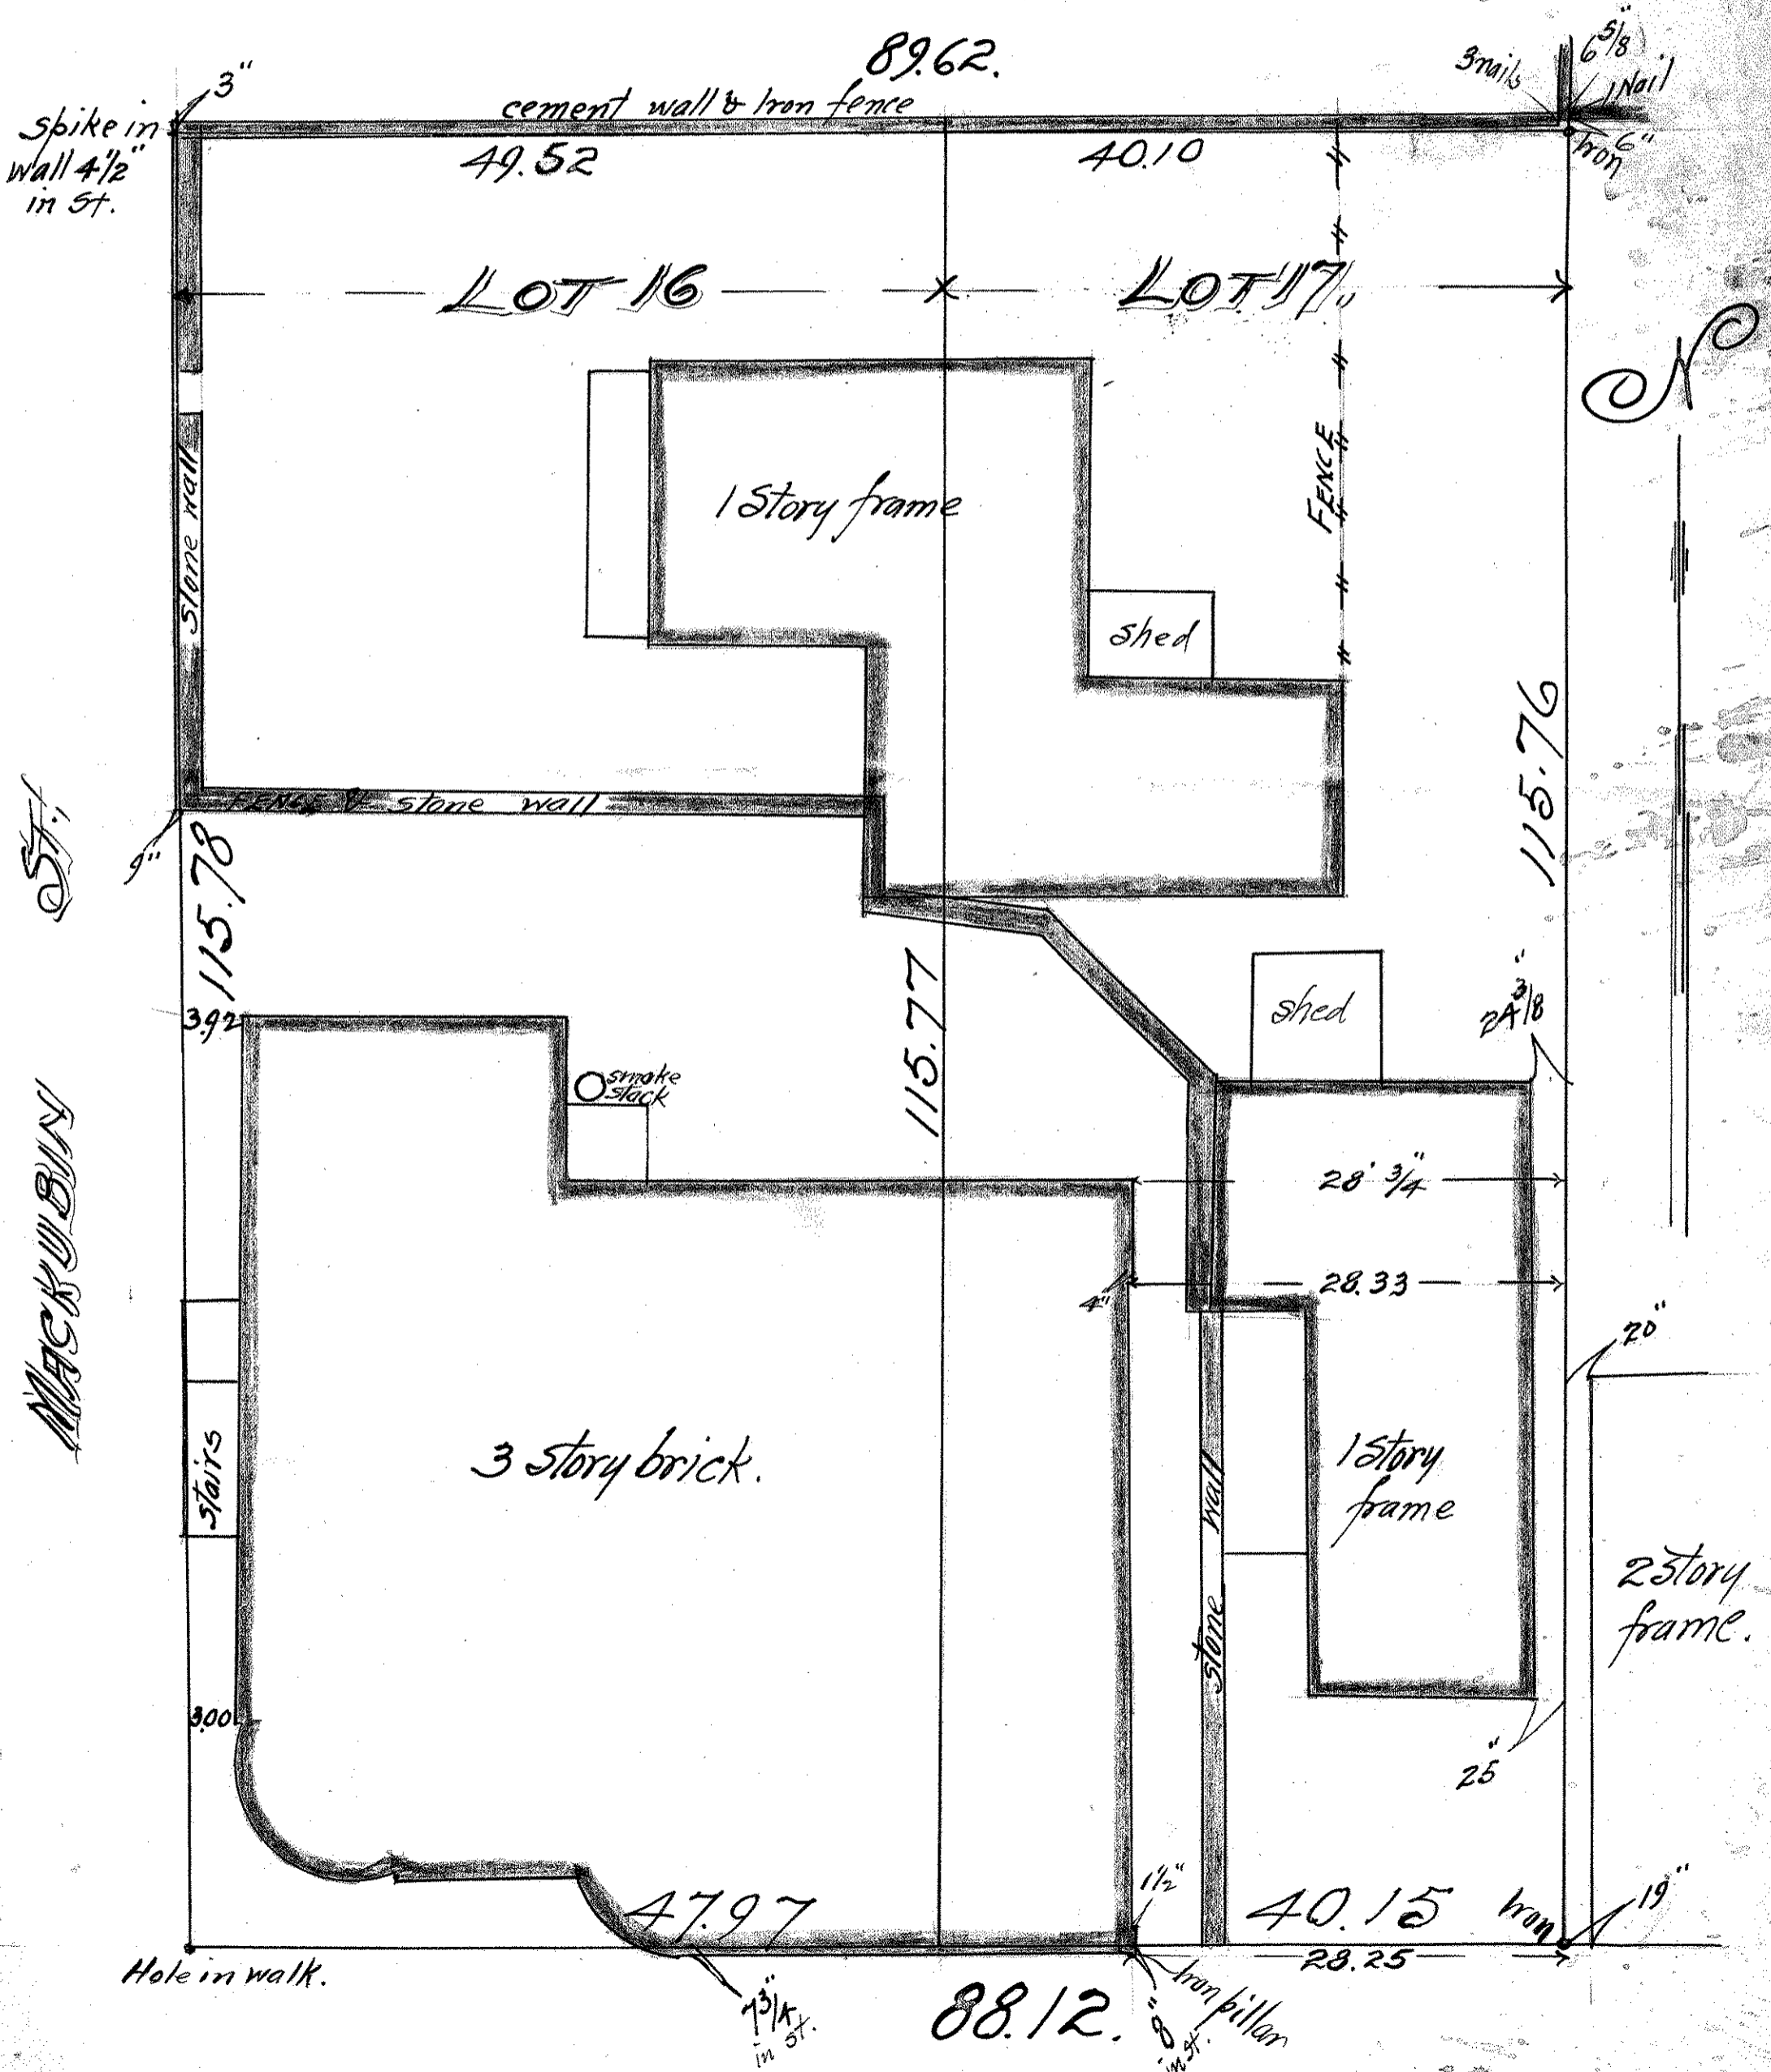

SELBY AVE.