


PLAT OF SURVEY

OF PROPERTY OF B. S. GLOMBITZA, M^CCARRON & SHADY BEACH AVE., ST. PAUL

DESCRIBED AS FOLLOWS LOT 20, SHADY BEACH, M^CCARRON'S LAKE

SCALE: 1 INCH 30 FEET
O: INDICATES IRON

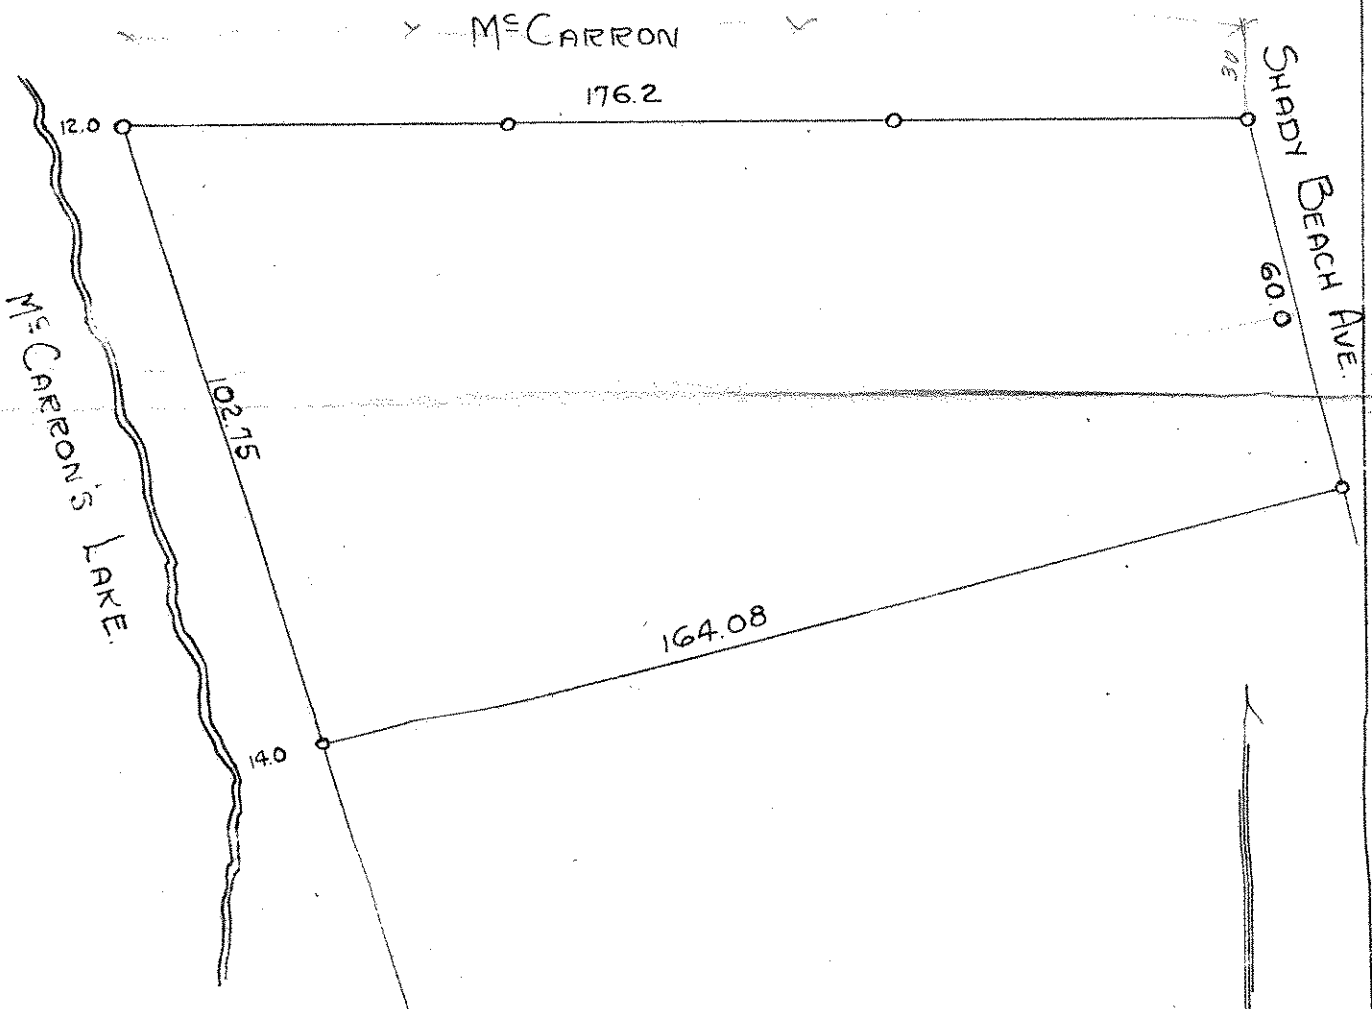

CERTIFICATE OF LOCATION OF BUILDING

I hereby certify that on _____ 19____
I made a survey of the location of the building(s) on the above
described property and that the location of said building(s) is
correctly shown on the above plat.

CERTIFICATE OF SURVEY

I hereby certify that on 3-24 1947
I surveyed the property described above and that the above
plat is a correct representation of said survey.

E. B. McDonough

E. B. McDONOUGH, REGISTERED SURVEYOR, NO. 1990