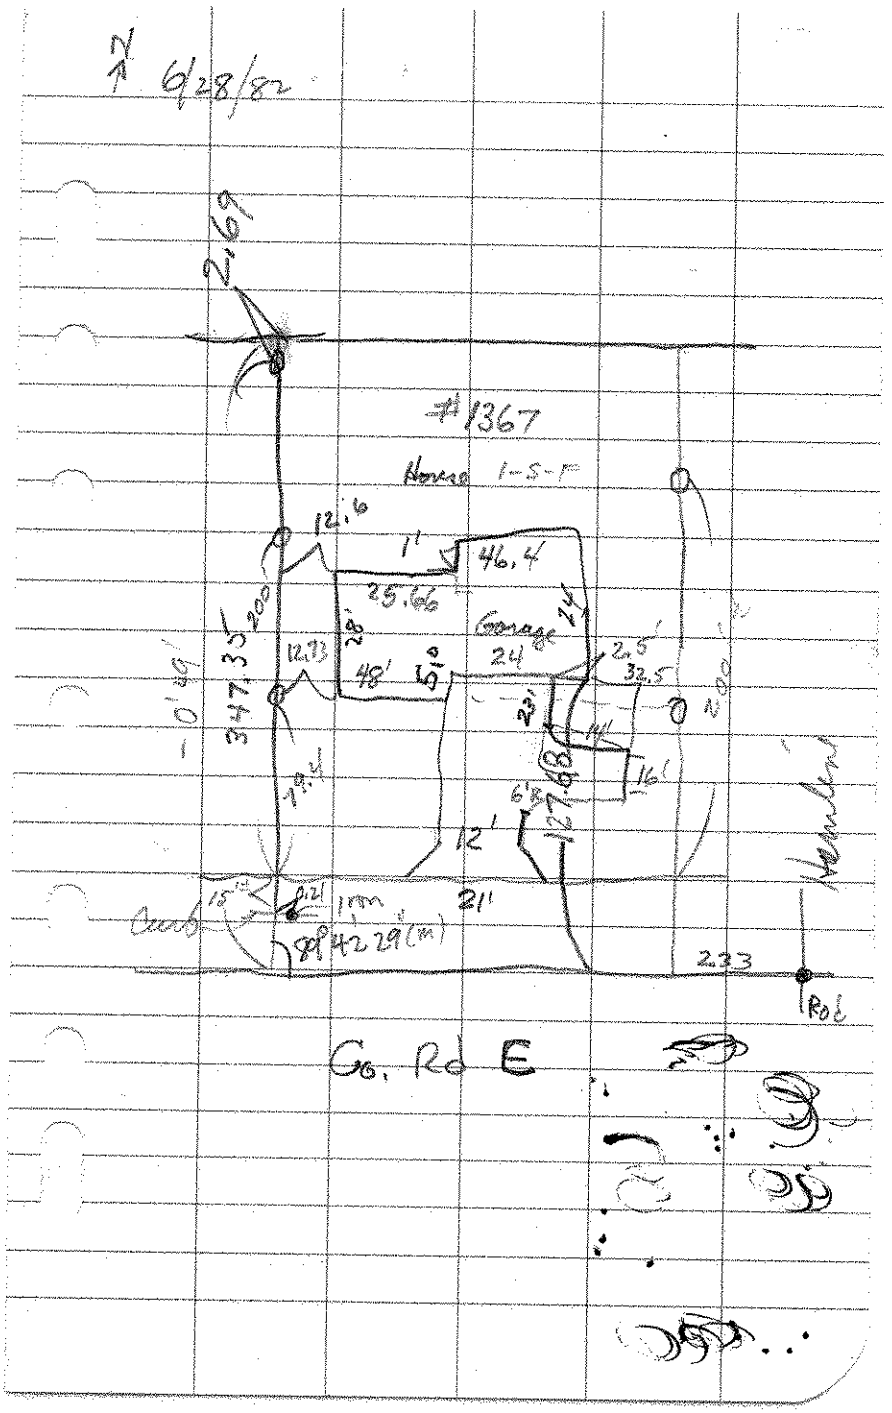
N
6/28/82
2.69
#1367
House 1-5-F
12.6
1'
46.4
25.66
Garage
24
48'
24
2.5'
32.5
347.35
12.33
19.4
6'8
127.48
16'
12'
211'
15'
8.21
1.00
88°42'29"(m)
233
Rd
Co. Rd E
Hemlock