


PLAT OF SURVEY

OF PROPERTY OF *Karl A. Plain.*

DESCRIBED AS FOLLOWS *Lots 18, 19, 20, Block 5, Shadyside Add'n. to Bald Eagle.*

SCALE: 1 INCH ³⁰ FEET

T. J. WELCH, REGISTERED SURVEYOR
738 SURREY AVENUE, ST. PAUL, MINN.

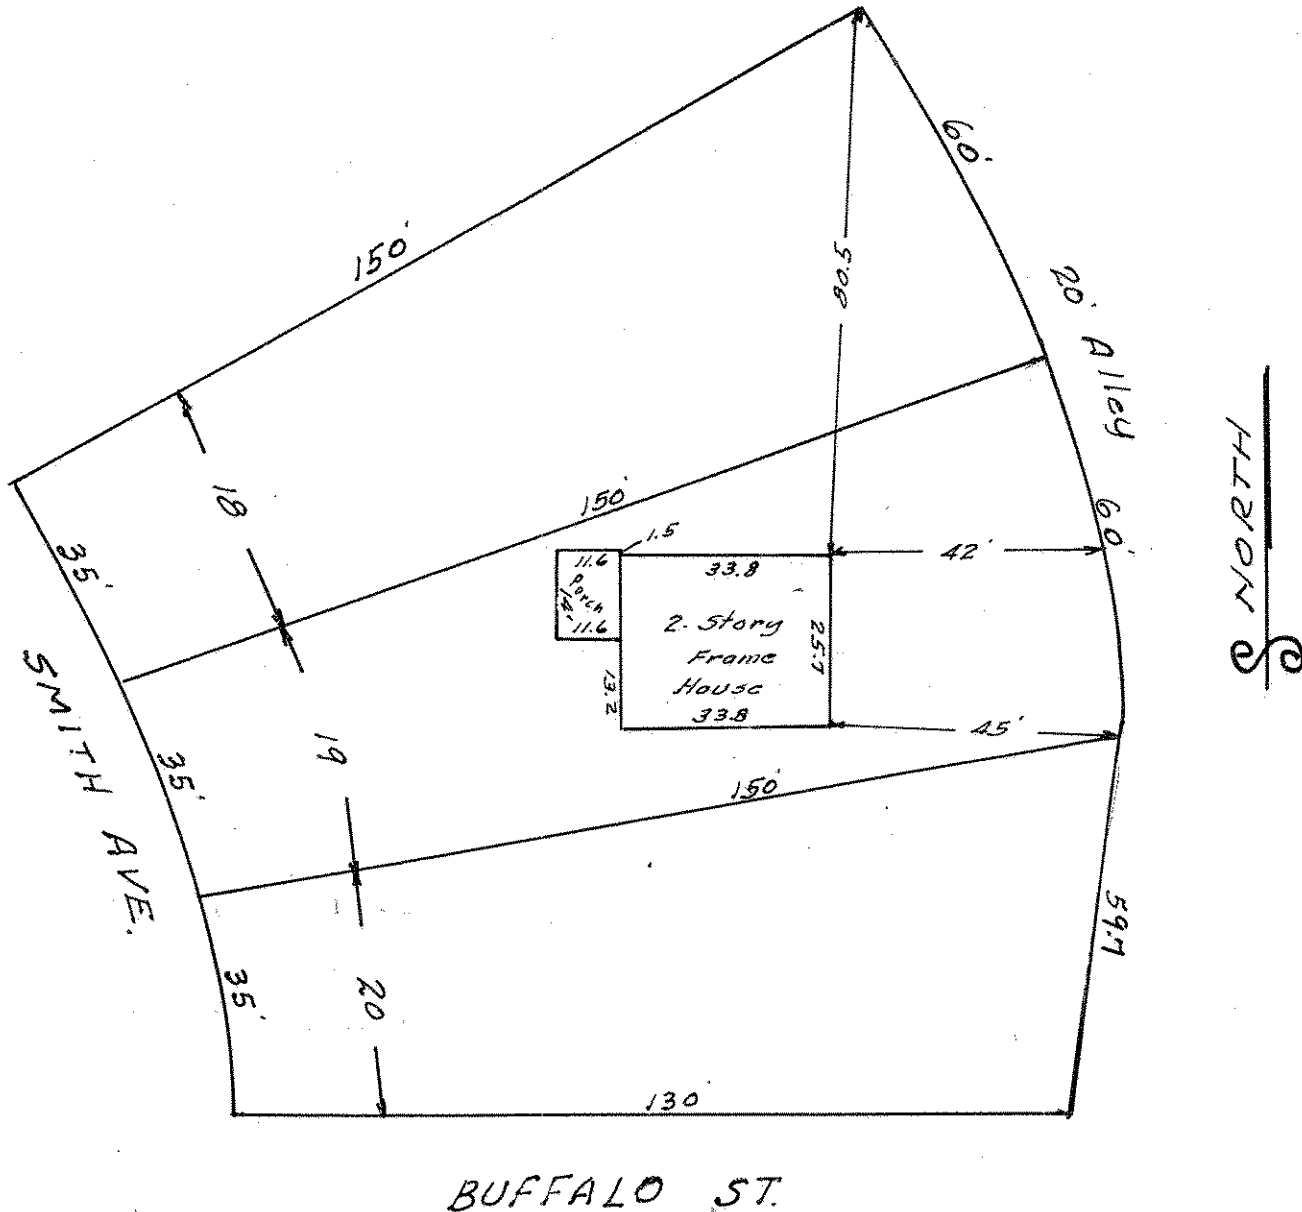

CERTIFICATE OF LOCATION OF BUILDING

I hereby certify that on *Dec. 19, 1941*
I made a survey of the location of the building on the above
described property and that the location of said building is
correctly shown on the above plat.

T. J. Welch

CERTIFICATE OF SURVEY

I hereby certify that on *Dec. 19, 1941*
I surveyed the property described above and that the above
plat is a correct representation of said survey.

T. J. Welch