~ PLAT OF SURVEY ~

Appl. 47462 Homer F. Broggeman

All that part of Lots 13-14-15-16-17 and 18, Block 1, Shady Side Addition and that part of Gilbert Avenue (vacated) lying East of a line 100 feet West of and parallel to the East line of Government Lot 1 - Section 12, Township 30, Range 22, and West of the East line of said Gov't. Lot 1 and South of the North line of said Lot 18 produced East, all in Ramsey County, Minnesota.

№ 2377 Taylor Ave., White Bear Lake, Minnesota.

SCALE: 1" = 40'

T. J. Welch
Registered Surveyor
701 East 3rd Street
ST. PAUL, MINN. 55106
TEL. 776-0640
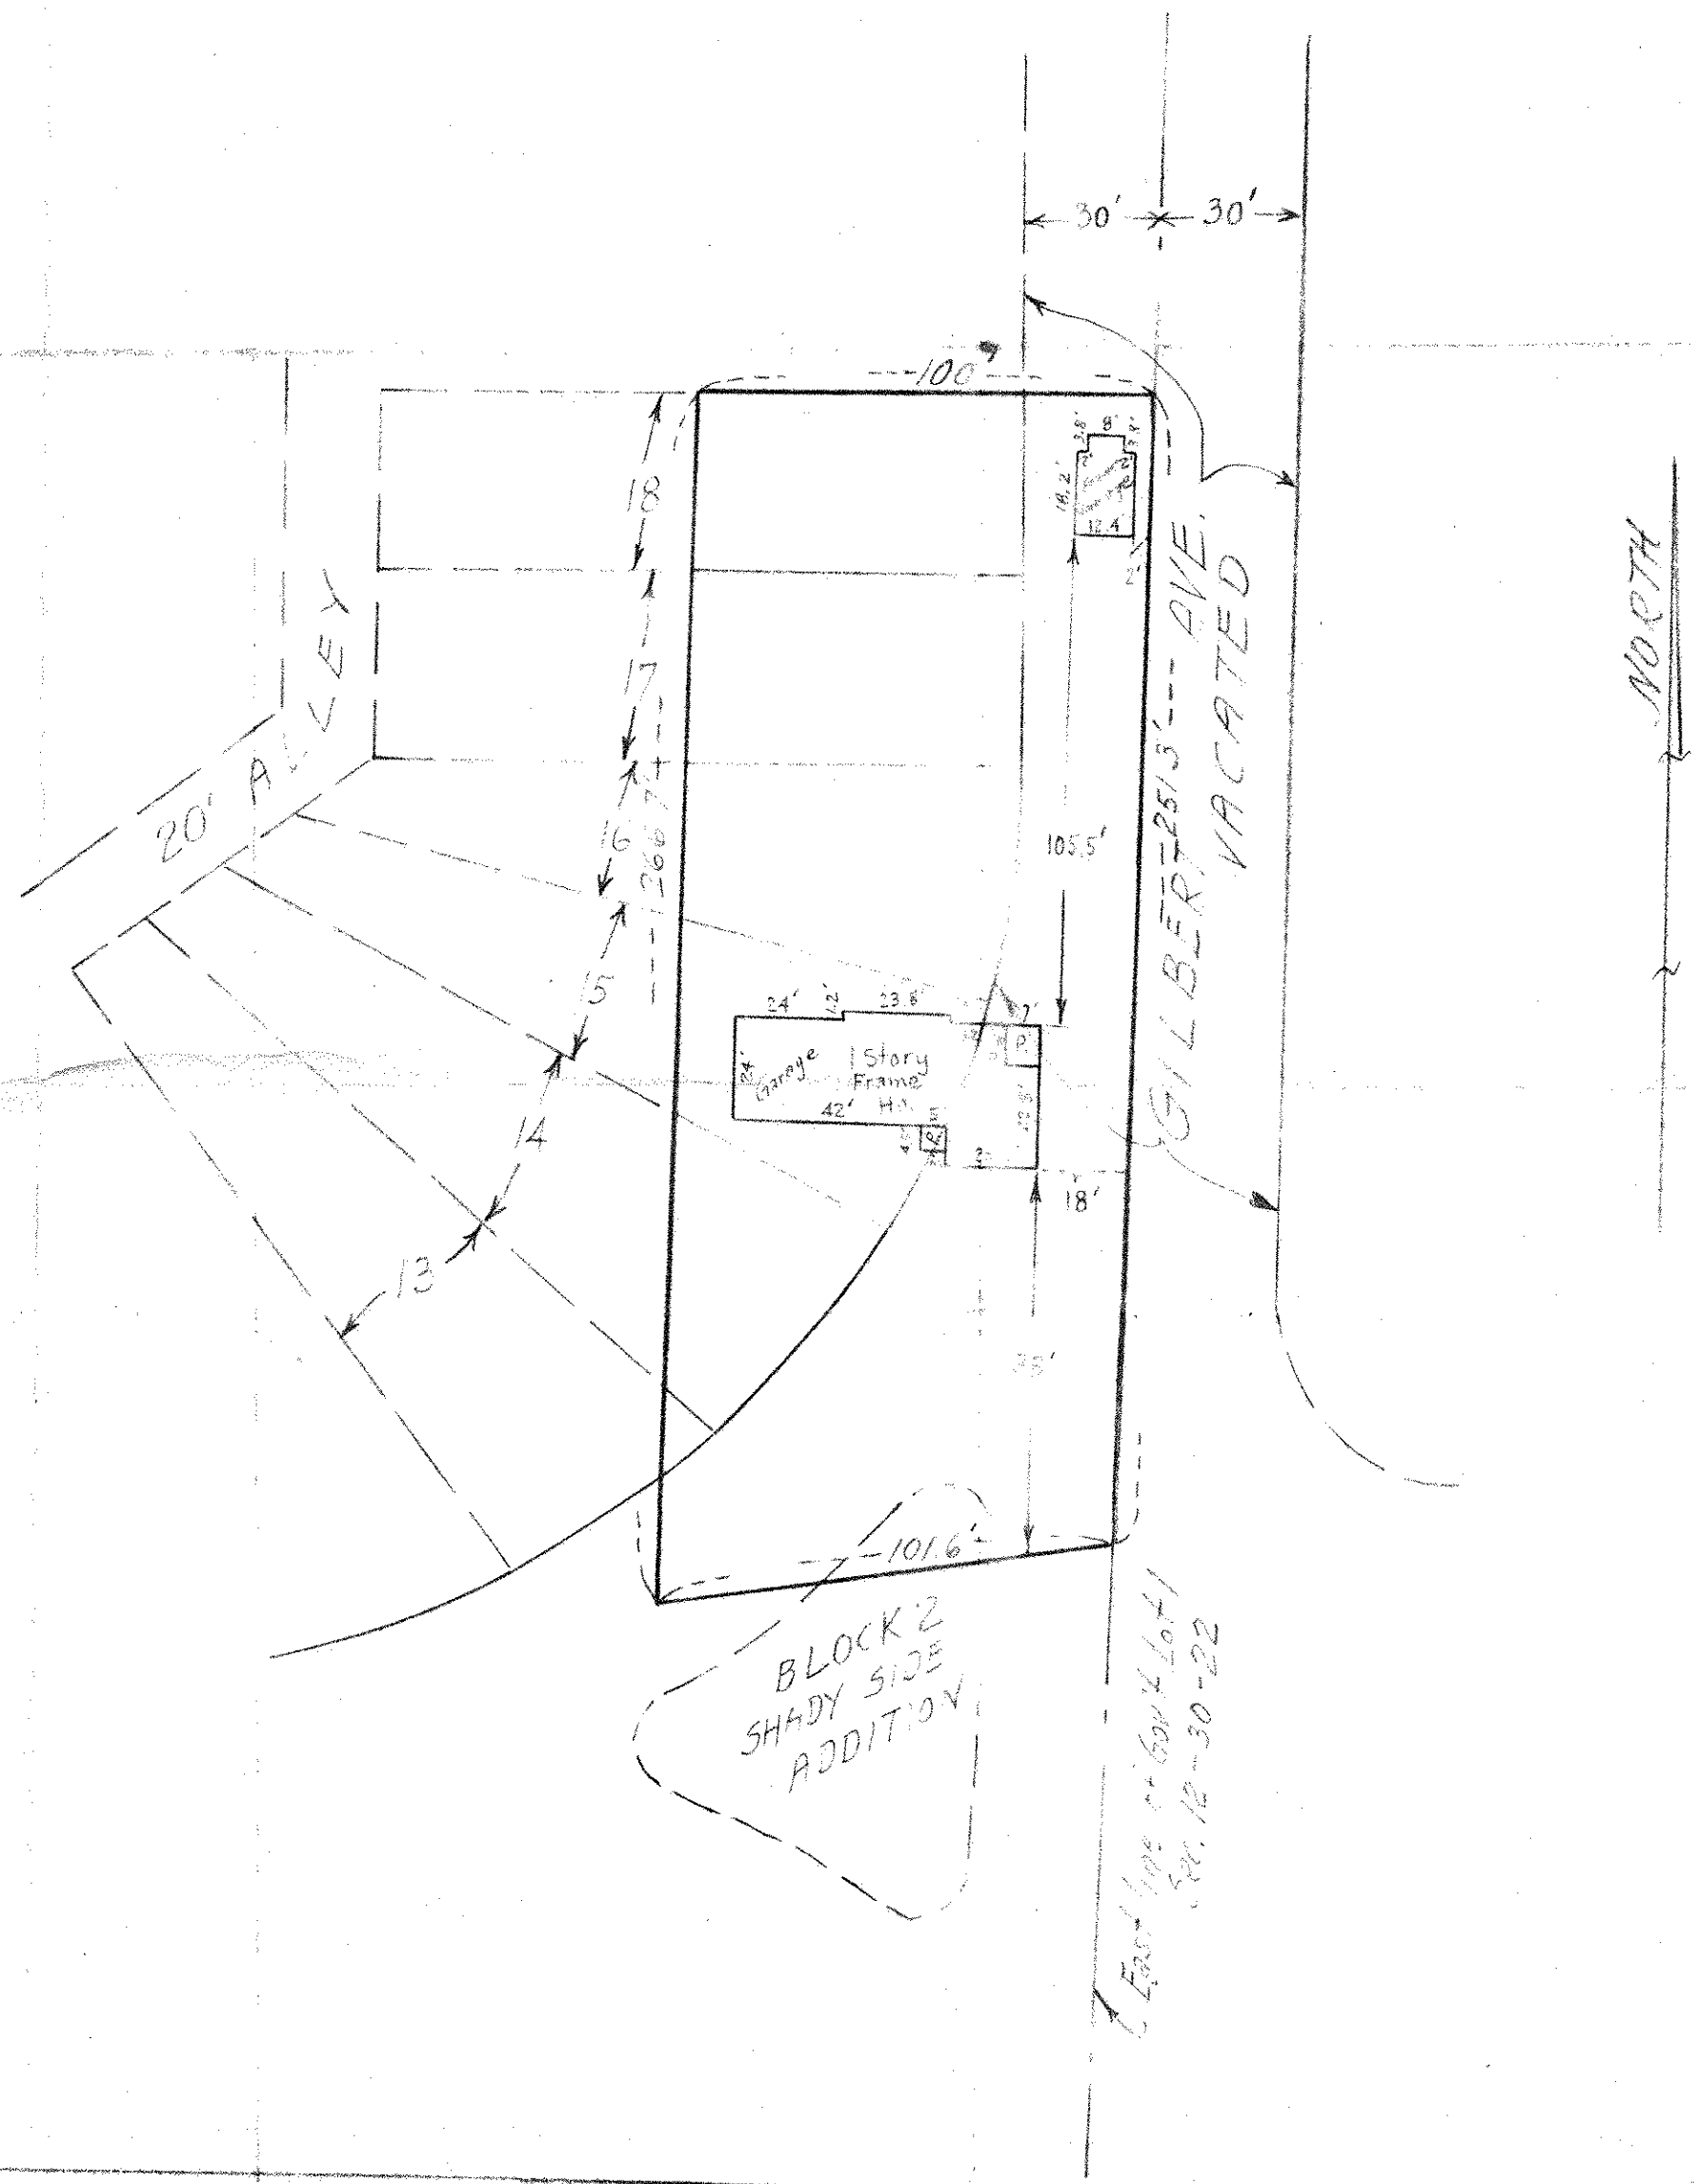
November 7, 1967