

CHARLES O. GEORGI COMPANY

2215 West County Road B

Saint Paul, Minnesota 55113

REGISTERED CIVIL ENGINEER AND LAND SURVEYOR

Certificate of Survey

I Hereby Certify that this plat shows a survey made by me of the property described on this plat, and that the corners are correctly placed as shown, and that all locations have been correctly shown.

Surveyed For.....*Ralph Grant*



Date.....*August 1967*

Scale.....*1" = 50'*

By.....*Charles O. Georgi*
REGISTERED LAND SURVEYOR

Description:

*Lot 5,
Block 1,
Sharondale Addition
Ramsey County, Minn.*

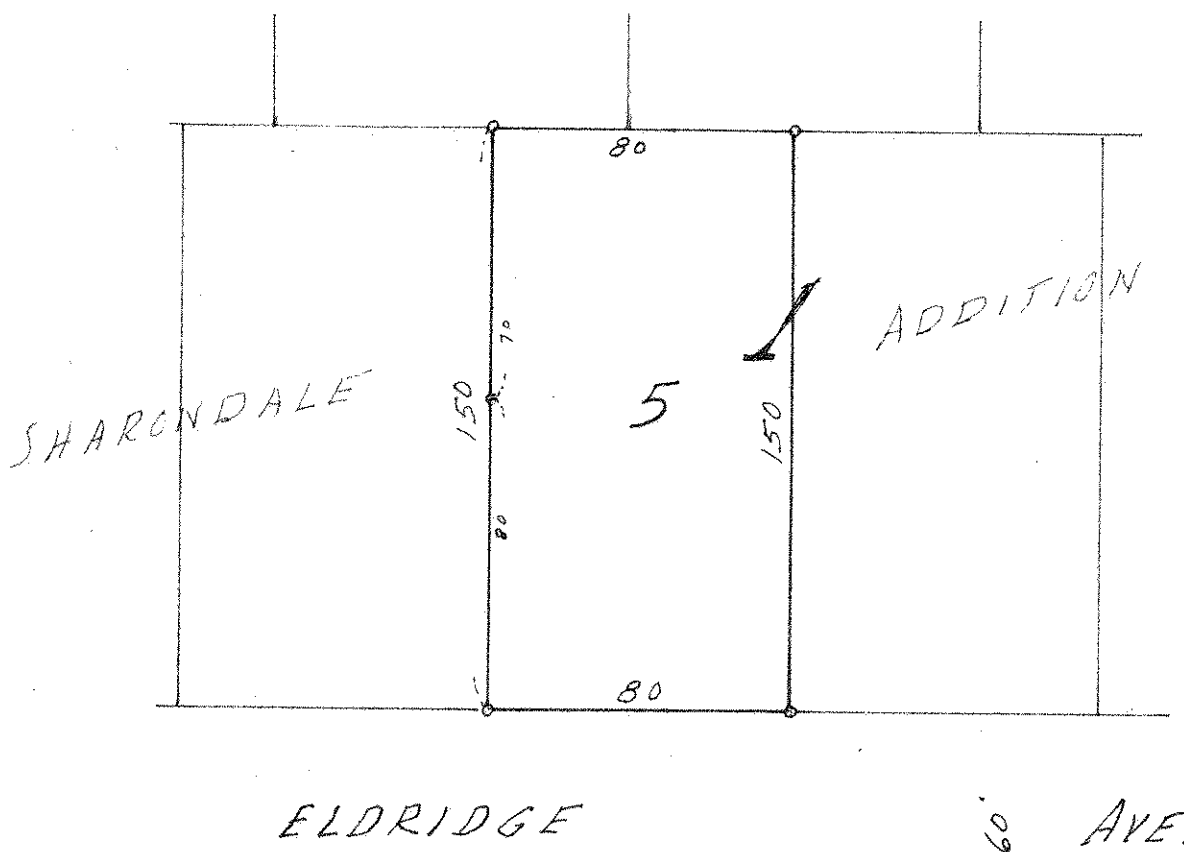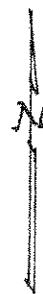

o Denotes Iron Pipe Monument.