

EAST 1/2 LOT 2.

THOMAS E. SIMIE'S SUB'D.

LOT 1 BLOCK 8

HOME CROFT.


JOHN B. IRVINE, SURVEYOR.

JULY 29-1916.

I hereby certify to having surveyed the East 1/2 lot 2. Thomas E. Simie's Sub'n of lot 1. Block 8 Homecroft and located the one story dwelling thereon as shown by this map and the same is correct.

July 29 1916.

John B. Irvine Surveyor.

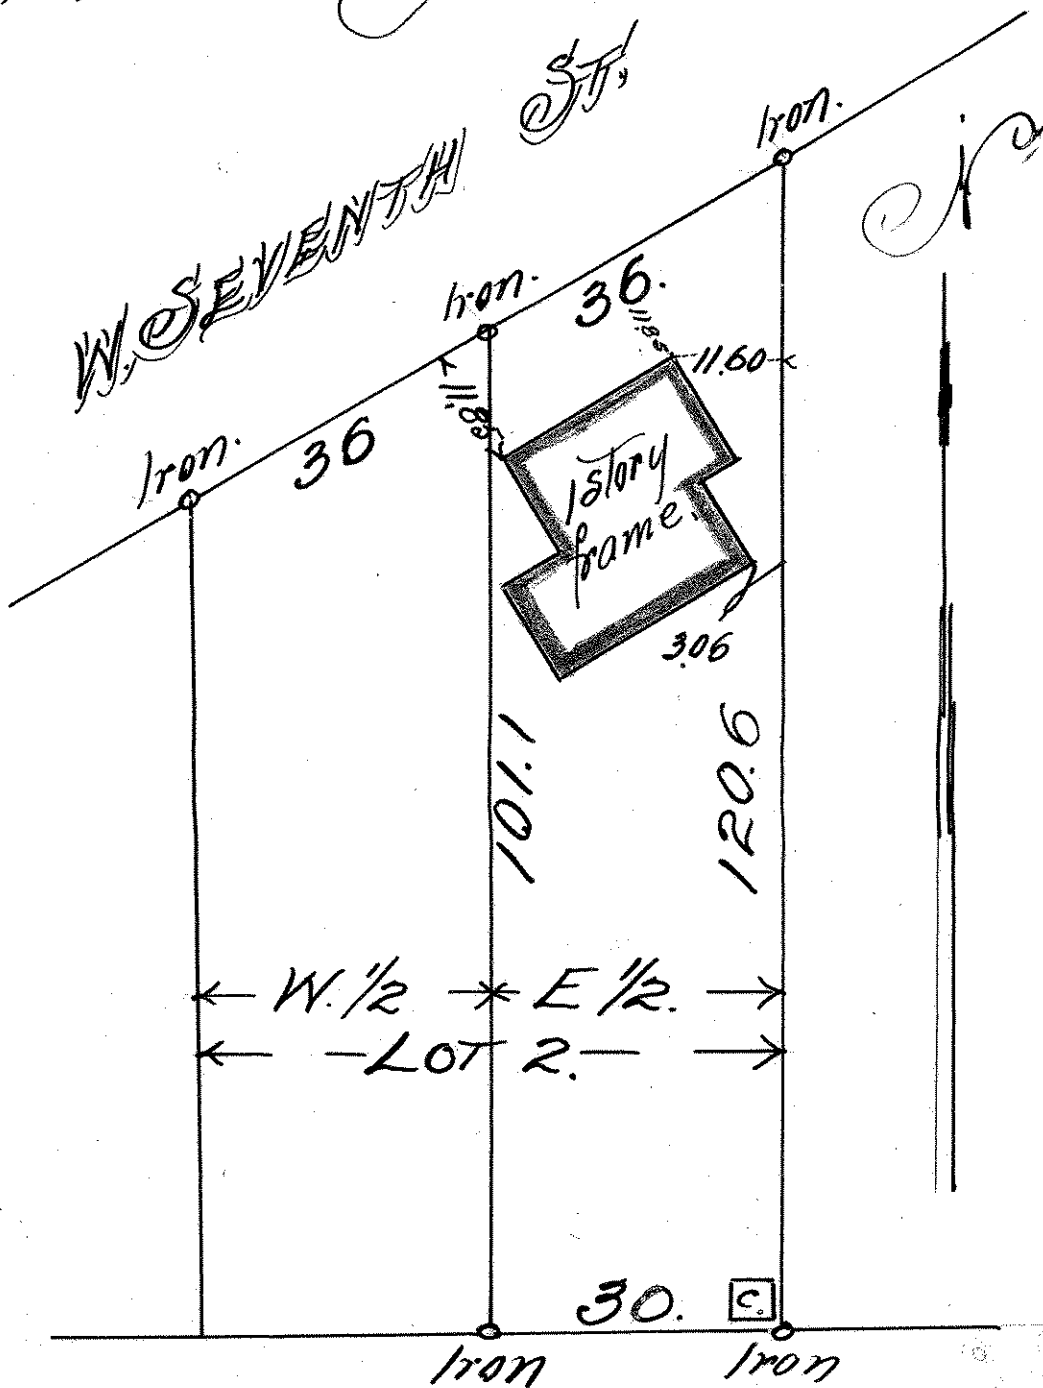

scale. 20ft. per inch.