


LOT H  
SIMPSON'S ADD.

JOHN B. IRVINE, SURVEYOR.  
408 GLOBE BLDG.  
ST. PAUL, MINN.  
APRIL 16-1915

Scale 20 ft. per inch.

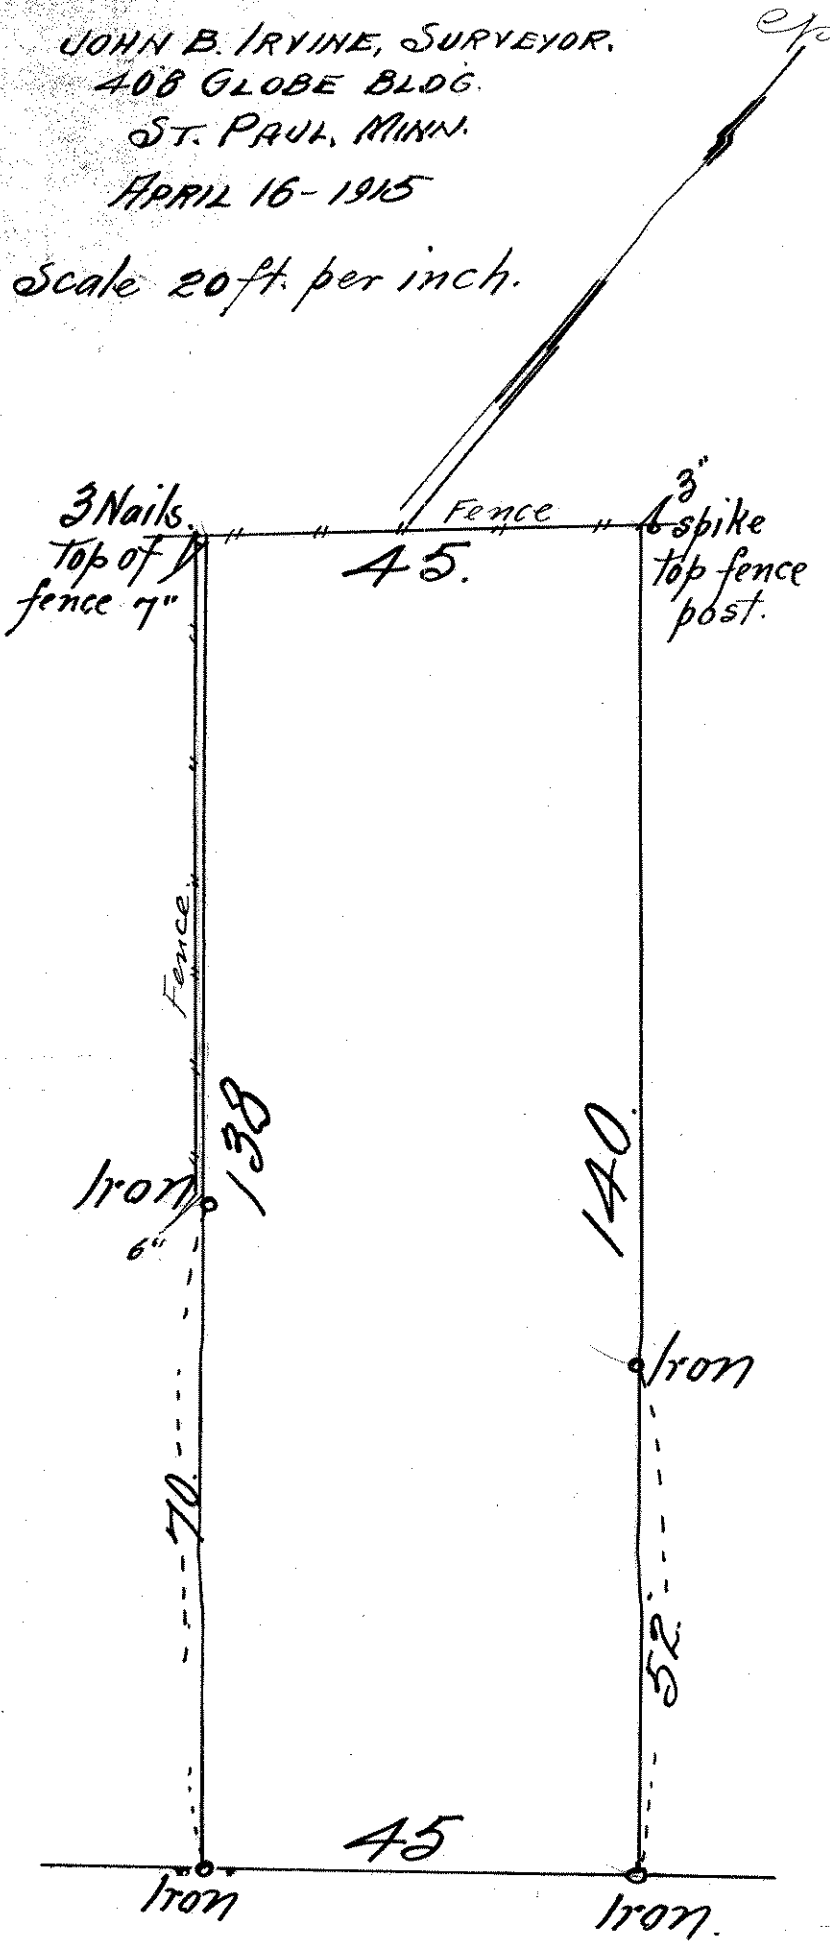

GLEHART AVE.