


LOTS 3 & 4
SINNEN'S SUB.
BLOCK 10

LYMAN DAYTON'S ADD.

JOHN B. IRVINE, SURVEYOR.
416 GLOBE BLDG.
ST PAUL MINN.
SEPT. 6-06.

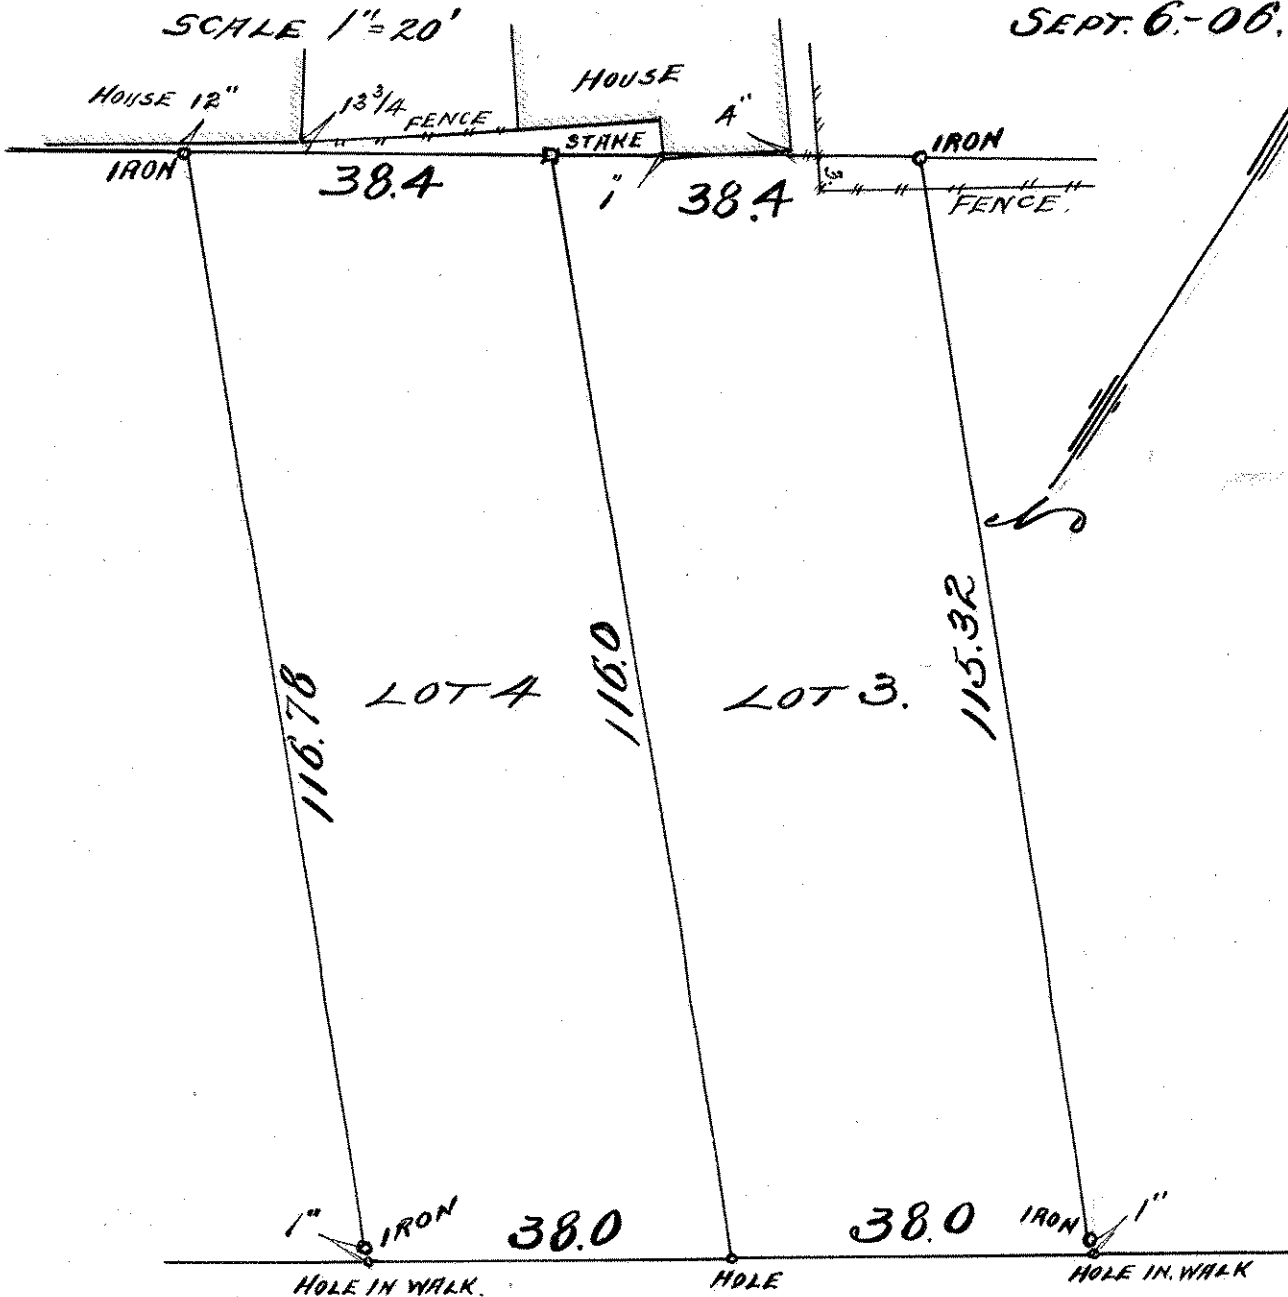

E SEVENTH ST.